X 11-24-72 set C/M over stone found and pipe (1) removed corner log used as corner.

#733304

1/4 corner South 1/4 33 Haverhill 10 1-13

10-1979 Shot north 1/4 corner in control survey 4 Marion 106-13

4-1878 Hunter P 333 no 327 S 4 N. Brackenridge.

See also T.H. BK 5 P.48

Corner gone. searched carefully by digging.

Mr John clark owns he set his fence on west boundry of his land in line running north from standing stake set boulder as corner in line fence north and eastward.

– corner lies 5.8 lks north and 3 lks west of corner fenced

– 16 west set stake M & L 20.18. 1331.88 – meas East 39.49 39.52

– west meas To east RW of railroad. 11.95 (788.7

– south meas To north RW of railroad 9.38 (619.1

– " " " & track of railroad 10.35½ {683.43

– meas south To center Sec 4. 39.12 (2581.92 calc.

8-1884 Hunter P 391 No 382 Dec 33 J williams
found stone set P 333 M Hickey.
58 links north and 3 links west of corner fence south.
– West 11.95 to west R way of RR tracks.
25.95 from west R way RR tracks to S W cor 33.
– south 9.38 to north R way RR tracks.

11-18-1892 Thos W Fraser P 499 No 470 S 33 Town Board.
ground frozen, used fence corner south as witness To set
point enough To set temp point at Center sec 33 no mear

Co Hwy Dept.
corner used many years. – 3/4" rod may be C I M 1968.
Spike power pole. S 28.9.
Disc tile pole. NW 72.13.
" wood span Culv headwall N 52.92 683.1
6-1969 reset corner with rod. – proved corner by mean to C & R R southeast
set 3/4" x 36" pipe up 3" south on transit line see card #2

#733304 (2)

Card # 2. S 1/4 33 Haverhill 107-13

N 1/4 4 Marion 106-13.

6-1969 J Kerr.

united reference drone 1/2" rod as corner. which came south of road surface in finished shoulder - To prone corner measured south to railroad pin.

Hunters notes - ∅ to N RW 9.38 (619.1)


∅ to ℄ RW 10.35 (683.1)

both mean proned as near perfect as possible without running N-S 1/4 line

set transit on corner as set with line on discin. wood span headwall culvert projected line south

-over-

100' drove 3/4" x 36" pipe left up 3" on this line which came about 3' west of N-S fence in wet grassy lands.

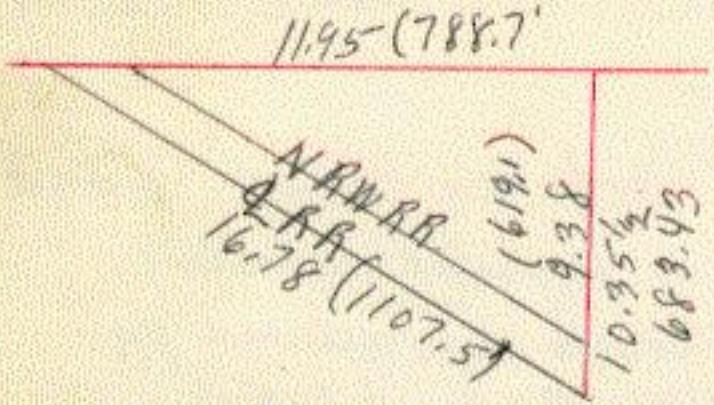

Hunters holes on N 1/4 4
P 333 No 327 4-1878.

10-13-72 offset 335' east run aerial from same offset at 1/4 28-33 area no N-S meas missed corner post at center 33 (329.8'

10-16-72 elec meas S 1/4 33 to S 33-34 mons no place 2603.14
Co meas B 75 P B 2605.0 Meas west 2662.8 elec meas 2663.49
- S 1/4 33 10.25 S of direct line S 32-33 and S 33-34

Oct. 1857 John Fellows Pg 41 No. 63 shows Mc West with meas. 19.90 chs. West to Sec. 32-33

Card # 3 south ¼ 33 Haverhill 107-13 #733304 (3)
north ¼ 4 Marion 106-13
Not satisfied with corner as set dug massive hole to deep water from corner beyond fence running south. found limerock fill and very wet black soil below. no stones in dark soil.
11-21-72 rand line from ¼ 4-9 north on 35' offset shifting at center ℄ point to 45' offset east. line fell 32.63 east ℄ C/M on meds ℄ 715.07 north ℄ center RR at point where random crosses rails.
11-24-72 found N ¼ 4 L stone in equally deep hole, wet. 6.17 west ℄ C/M or. 38.8 west ℄ random. Comp distance random at 683 even to be 39.6 ℄ which would be 31.81 north ℄ tracks at random to point opposite where ¼ line crosses tracks at

51°14' angle in random. Rec 683.26 ℄ to stone on ¼ line ±.
R. 683.43 or .50.8 N.W'ly along ℄ tracks to N-S ¼ line
believed to be very near line of fence south at that point
- stone found in N-S position long part of stone. 4" chuck
near point to 12" wide ± at bottom at least 16" long
not a boulder. corner proved itself by above meas.
- remove old C/M and points below. set several cans
of old lead by stone with 3' long ¼" pipe over stone & C/M
in top. took new set of RP's. Center $ 338.03E of direct line old RP's
53.55 N'ly to old dice in S end wood Culv hdw. ~~52.92~~
68.69 N.W'ly to old dice NE side heavy cable Tele pole. ~~72.+~~
29.51 6' E of S. to grape cap on W side PP #1906 8. ~~28.9~~
27.12 SW to angle punch hole E end top center 30" Culv.
Meas west now to $ 32-33 as now in place. ~~2651.32~~ ~~R=663.76~~
2659.38±



#733304

(4)

Geic Notes

40.0 Iron pipe 1 foot above level 1/2

Section corner. Bell found with mark

Placed S.E. Offset Corner, 1 N.E. Hub & tack

5-23-89 C.I.M. down in gravel shoulder 15" South side of Co. Rd. 9 Note: ℄ CR 9 North 16 1/2'