11-17-77 CIM

#740406 (1)


1/4 corner 4-5 Cascade 107-14

6-1917 J Kerr P270 B- B-10 (1917) P19 L5-6 chas young.
found no corner. - found stones north and south.
- set stone as corner on section line
from SE corner 5 north on line 2626 to stone
then 1313 to stake as 1/16 corner then 1281.0 to stone
long recorded lately used by D Williams P240 B.
- divided N 1/4 entire section 5 into square 40s.
- meas west 1317.9 4 times setting stakes only.
see Center 5 picture plat.

11-17-77 Set a CIM (deep) over a ½"x2' rod ~~at the intersection of~~ on the line from NW 4 to SW 4 and in line with fence E. Corner set so Taylor Center 4 iron E-W ¼ line. Corner comes in cattle lane in line with fence N and E, 1½' So of fence W and 3' W of East lane fence South.

RP's CSD in N. side of power pole E. 18.04

Sp. a CSD on W. side of wood post S. 31.54

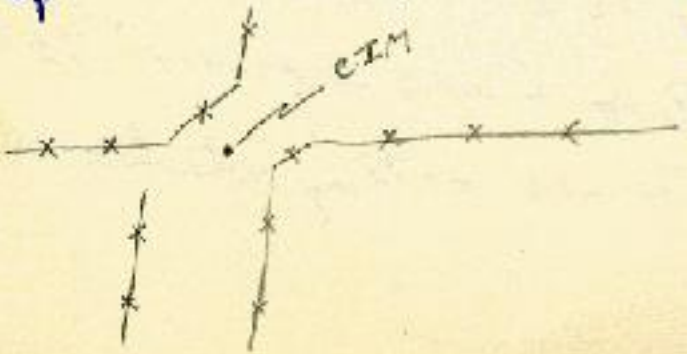

*Cascade 1/4 corner 4-5 #1740406 (2)
Good Rocks mtn. Branch 1854
40.00 set temp 1/4 creek pool
South on true line between
Sections 4+5
39.52 set 1/4 section post in mound
with, trench, pits, charcoal stake
+ Osage Orange Stakes NE+SW