
740509

1/4 Corner Center 5 Cascade 107-14

6-19 17 J Kerr-Dep. P270 B. B-10 P19 S5-6 C Young.

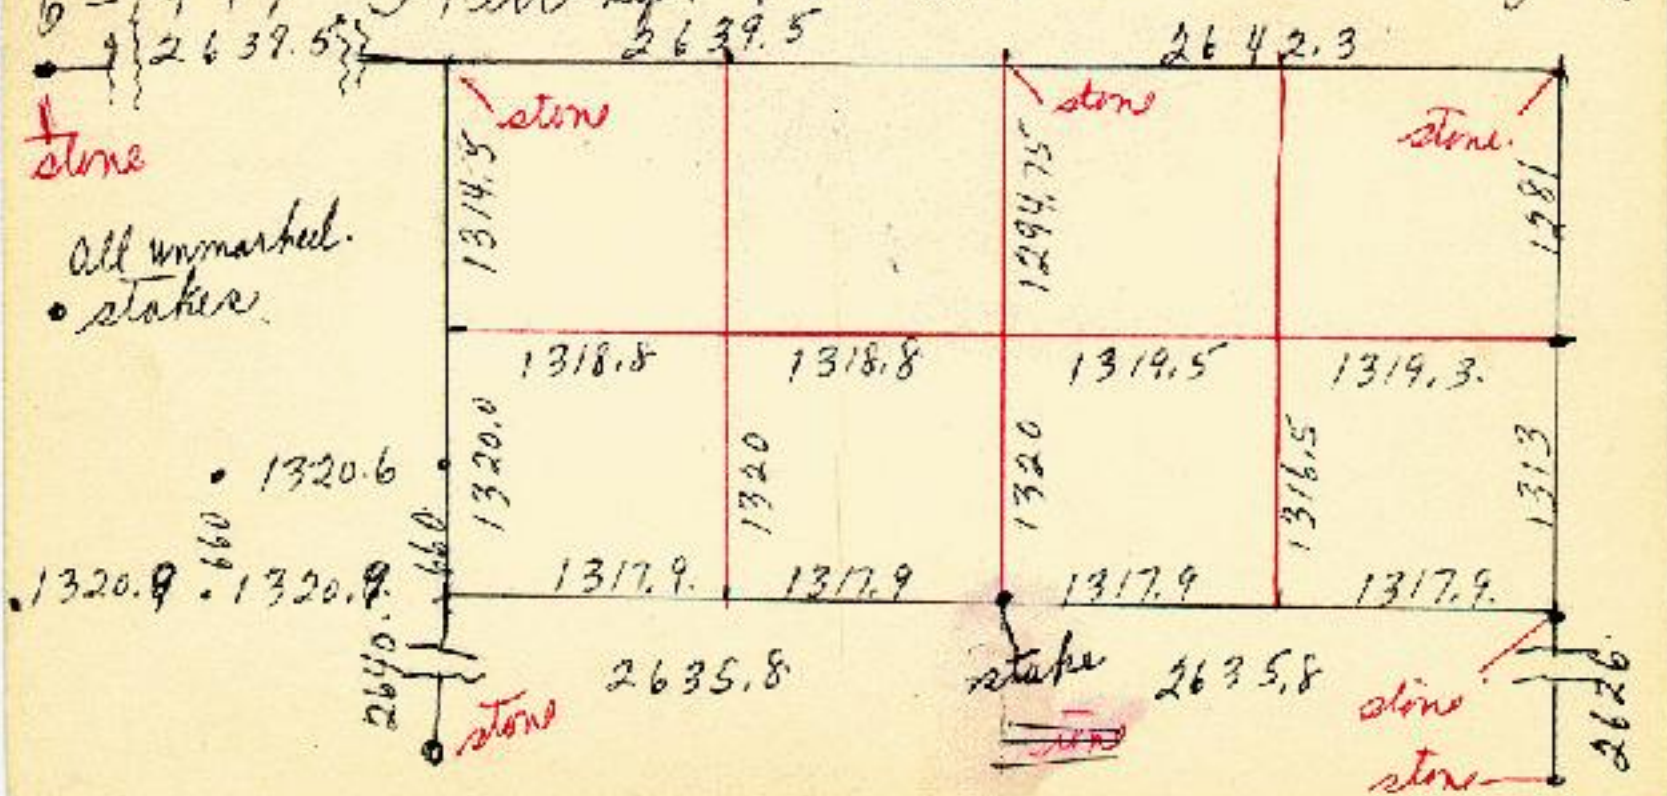

All unmarked stakes.