~~Corner falls on M.H. USC Knotches on M.H. ring to locate corner by intersecting the Knotches~~ Cal 22

1/4 Corner Center 15 Cascade 107-14 #74/509

No records Corner run in by McGhie true intersection placed small rod as corner.

8-21-69 J Kerr in re-referencing line to preserve corners after grading. old references gone except.


1/2" rod in nearly gone N-S fence west 37.55

found rod in road and above rod west.

nothing to RP to that will stay during grading

- set 1/2" rod 6" deep southwest 150.0' on 1% slope.

1 BM water tower with back az NE in exact center of corner post with brace west and north over.

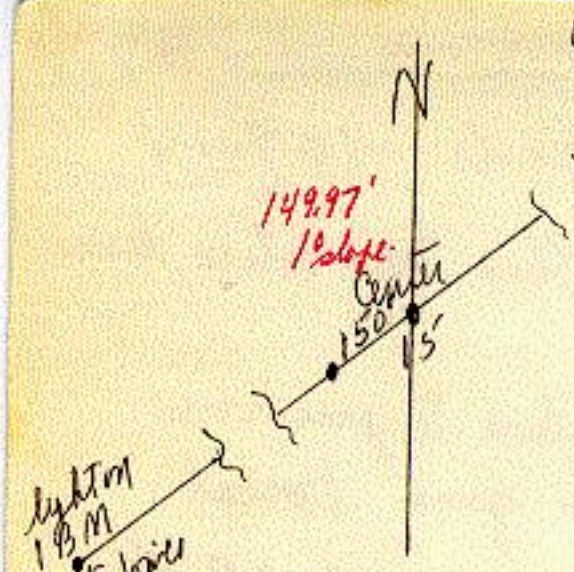

B 337 Co H D 1968.
Hubs - E 64.90, NE 83.32, SE 84.4
Corner a PI Sta 2631.4. Δ 0°1' rt going N.
Meas north. 2627.2.

9-23-71. found rod in field, hard to see both water towers and corner post due to tall corn on hillocks. used rod and corner post as final. Az & water towers from corner. 228°53'
RPS new - 136.5 to Tup cap E side Rock power pole Az. 339°
154.0 to Mountain Bell cap E side Rock power pole Az 198°25'
set ½" x 30"+ iron pipe da cor

N
brace post
corner post.
1x tall pole or post
25'± each
Iron est 5'
Center 15.
150'
light on IBM.
water tower.
1° slope.
149.97' ash.
9-23-1971
formed vert mi
trailed out
½" x 3' pipe on
line
AZ corner to brass cap
45° 53 SE W.
136.5 21° N to W
mag az is sub 11°
155.0 Pine-155
11° 25 S to W