#742409

7-2-1965 ~~set CIM~~ over orig 1 1/4 pipe. (1)

CIM Gone in Road Const. (1982)

1/4 corner Center 24 Cascade. 107-14

8-1876 Hunter P303 no 298 S 24 & Dodge, R. Smith.
T.H. Book 4 P. 146

set stone 4 x 8 x 24 as center section at inters lines
Set Center of N.W.1/4 Set stone 2 x 3 x 15

-16 West set stake M & L. 20.16. (1330.56'

-16 North set stake M & L 19.99 (1319.34'

3-22-1880 T. Hunter Bk 5 p 105 Sec. 24

Corner never found, set by inters lines. a 1 1/4" pipe that for years was under fence south side of road (a 2 rod road)

-B60 P25 May have set center then about 1954.

Meas west 1489.01 To NE cor Art Morris Subdiv 1171.06 west to 1/4 corner 2660.07 a meas south 2630 ±, a stadia line run at one time records lost. 8-1955 B.

-B68 P73 Meas due east 2611.44 set pipe at 1305.72 and then 652.86

OVER.

B79 P60 9-1959 run line north from 1/16 east 2628.9
set 1/2" at 1/16 1314.45 - other lot corners now in place.
-7-1965 set C I M after road grade complete Corner now
in center road. - rod north 1150 - Dec PP NE 49.72.
Kerr BK 90 P.15 - Rod + Hub North - 115.00
oo in west end drive culvert NNW 25.38

-16 east iron M & L. 1305.72 { Dec PP NE 101.5
SW cor garage N 94.35

-16 west iron M & L. 1330.3 { Dec PP WNW 37.5
120 D in 16" tree NE 54.25

Kerr. B.25 p.57-58 8-15-1941
Set 1½" iron pipe @ Cen. Sec. 24 5' W. & 8.5 So. of present to Cor.
2660.08 from W. ¼ Cor.

July, 1857 John B. Fellows Pg. 29 No. 46 Partial Survey of
S.W. ¼ N.W. ¼ Sec 24


1/4 Corner Center 24 Cascade 107-14 (a)
#742409

4-9-81 Found CIM OK.

4-9&13-81 1/16th East: Dug down at 1/2" rod found in blacktop road. Found 3/4" pipe 18" deep .14 North and .07 West of the rod location. Left pipe in place. Set a 1/2" rod back at its orginal location at road surface. There was also a P.K. nail .36 South of the 1/2" rod before we dug.

4-10-81 Kerr prop. cor. 208.71 of 1/16 East: Dug down 2'. Found 3/4" pipe. Left in place. Set square headed bolt at road surface.

7-16-82, 1/16 West: Measured West (recorded distance) from Center 24. Found point came near center of 12' wide patch in blacktop where sewer had been dug across. Could dig nothing, assumed destroyed

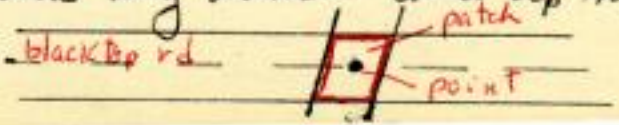

7-16-82, Center 24: Dug from CIM location as follows:



The CIM was over a 3/4" rod inside a 1¼" x 36" pipe. Natural ground down 4'; Clay down 5'. Found a post mark in clay 1.6 East and a blank mark we could not identify as anything particular 1.3 West of the pipe. Drove pipe well down into clay. Found nothing further

CIM { C.L. W 7.00
C.L. N 7.61
P.K. E 4.99
P.K. N 4.99

Took RP's to CIM location: Set 3/4" re-rod 100.08 NNE in ℄ driveway and on line to SW corner of concrete block garage attached to house.

"742409" E 12-11-97 mw EA 19

Center 24 107-14 Cascade we Traversed in 1988 60d spike location. This position Fit mrs. sehl's Certificate tie on 1/4 line of 724.18 shot 724.18. shot pipe w/cap @ NE Cor lot 13 Blk 1 Northern slopes Third Sub 97.45 plat= 97.43'. Dist to CH. D. P.T. (Capped pipe) 105.05

Set 1" sq. pipe w/cap as Center of Section @ long used location R.P.'s

℄ E.B. Lane CSAH 22 So. 26.8' line of West wall garage of House (1115) North of Corner East 23'

The Corner Falls on the very North Edge of the Blacktop Left Turn lane into Frontage Road