#743306 (1)

X 6-18-75 Set a ¾" rod - Witness Corner

¼ corner. 32-33 Cascade 107-14

10-1894 Jr Fraser P 554 no 511 L32. L Frutch. Eagle.

found corner post marked by Hunter as ¼ corner.

-16 west set stone and stake M & L 19.84.

-16 north set long limestone M & L 20.08 (1325.28'

Corner for years in cultivated fields (Judd farm.

3-1954 J Kerr B57 P64 J Howe

run a meas sec line betw 32-33 (5296.96'

set ½" rod at M & L 269848 which was last as corn.

as C C Manor started unless tied to plat.


- east set for Howe SW cor 60 acres at 1949.74 from center of 33 total half mile (2599.65'

6-18-75 Reset a witness corner with ¾" x 12" rod 101.62' west of actual corner location and on the E-W ¼ line of Section 32. For E-W control we used a distance of 574.88' from a ½" pipe found on the east line of Country Club Manor.

R.P.'s To Witness Corner

NW corner of Harriet Bishop School NE 47.96'
SW corner of Harriet Bishop North of the main school entrance ESE 67.43'

Corner falls 1.4' W of the N. side of the N-S sidewalk

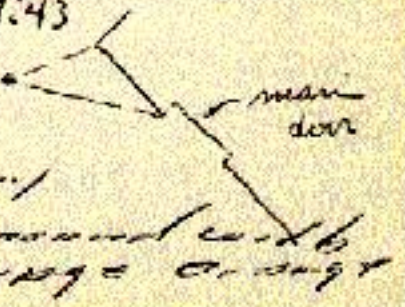

(2)

1/4 Corner 32-33 Cascade 107-14

May 1857 Thos. Hunter Pg. 23 No. 37 used 1/4 Post #743306 1/16 North 20 chs. m&L. Meas. East 39.33 chs. to Cen Sec. Caption from April 1886 Thos. Hunter 1/4 Corner missing Set fence post at m&L position. Total Distance for Mile at 80.31 chs.

11-87 1/4 Cor 32-33 : Witness iron gone but untied loc and shot (Drwg No 8-107-14-6). Also reshot CC Manor 1½" pipe. Redemp. Corner based on these two points and E 1/4 33 using drwg 3-57. See Drwg No 8 for coord.