X dug up T. Hunter 1885-1888 Pipe on Aug. 5, 1976 9.3' deep
Set above ground monu. in Mayo Park (#743605)

Section corner south 35-36 Cascade 107-14.
north 1-2 Rochester 106-14

original stone long in place, removed and replaced. ~~Corner now believed hopelessly lost.~~ (1)

Corner in Mayo Park south of auditorium.

8-4+5-1976 Dug at the projected intersection of 2nd St S.W and 3rd Ave SE. Dug 2'x2'x9½' deep. Found a 2" diameter pipe 9.3' deep in soil that appeared to be sediment from the river. Did not remove pipe which was solidly in place. Corner .21 N and .58 E of intersection point. Set ½"x25" rod to mold location.
R.P.'s CSD NE side light pole SE 54.64
Most NW'ly corner of lowest stone base (at top)

of flag pole  SW 43.03

Nails
N 6.15
W 6.58

N edge of concrete E-W sidewalk S. 23.50

On P. 29 11 of John Kerin's File No. 534 Hunter records placing this pipe in place of original corner.

10-18-76 Removed mod. Set CIM down 2' beneath historical monument (up 8')

Gone North,
[illegible]
Set [illegible] 12 N ½ W 77
" " 16 N 15½ E 170
" " 14 S 45 W 75
" " 14 S 71 E 25

SEC Cor. South 35-36 Cascade 107-14 (2)
North 1-2 Rochester 106-14 #743605

5-23-84 Removed above ground Monument for Construction of Attraction Center - left CIM. below

New RP's

Punch hole in retaining wall on eye line to ℄ of 3rd Ave South 100.18

Punch hole in retaining wall on eye line to South edge of Holiday Inn Building S.W. 134.81

C.S.D. in ± 30" Burr Oak S.E. 129.07


Note:
used E.D.M. & T-2 for Ties - See Remonumentation Book for Notes.

Also chained these Corner of Flag pole base S.W. ~~46.44~~ 46.48
C.S.D. in light Pole S.E. 54.71

See 1984 Remon. Book for sketch of CIM from Mn/Dot "Depot"

SEC COR. 35-36 CASCADE 8/25/86

RESET ABOVE GROUND MONUMENT FROM REFERENCES TAKEN 5-23-84 NEW RP's: PUNCH HOLE MOST S1/4 COR OF SIDEWALK SQUARE (.2 FROM E EDGE) NW 32.63, PUNCH HOLE IN MOST WLY COR OF SIDEWALK SQUARE (.2 FROM E. EDGE) NE 20.85

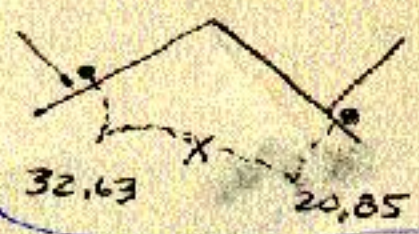

11/3/92 County Surveyor removed mayo monument for Corp. of Engineers Flood control project, used 1986 ties in conc. sidewalk to check drill hole NW 32.63, drill hole NE 20.85.

NEW RP's Face of S.E. cor. of Civic Center NNE 51.845

top of fire hyd. NW 76.64'

SECTION CORNER SOUTH 35-36 CASCADE 107-14 (3)
NORTH 1-2 ROCHESTER 106-14
#743605

9-11-95 DUG DOWN TO SET MONUMENT. WE HIT SPRINKLER LINE @ 10" DEEP RIGHT WHERE THE CORNER WOULD GO. WE WILL TRY ANOTHER TIME TO SET CORNER.