#750206

X

¼ corner 2-3 Kalmar 107-15

+ 1872 Hunter P192 no 203 L2 L Wilcox, H wade.

found 1/16 corner south above ¼ corner ~~19.84~~ north of SW 2.

10-1958 J Kerr B76 P58 L3 REA


found pinched end pipe driven at fence corner as ¼ cor 2-3 accepted as true corner


run line west set rod at 136.7 for SW cor REA

brushed & run stadia line to center section 3 a brg corner past

meas 2632 ±.

REA Plat

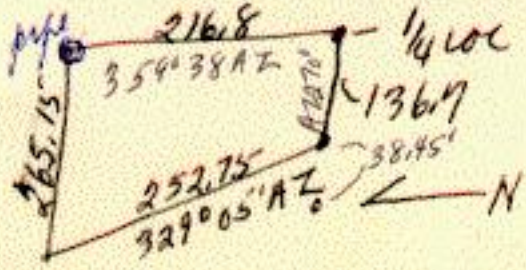

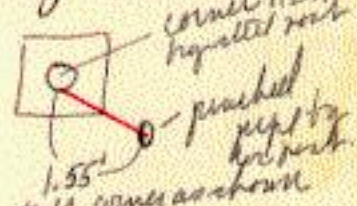

(over)

10-1969 McElhiney assist. to lay out land parcel bounded by east line section 3 and Wolterly road. offset 30' east 1/4 2-3 mean north.
Cont line north without further offsets, found pipe at NE cor REA
@ line came 30.21 east of NE cor REA property
offset 1' West on first hilltop. then @ 29' west
total to hole found & old stake 2648.0
line came 2.88' west of corner found.
NE cor RE A should go .44' east to be on line.

Govt Notes Kennick 1954
1/4 sec tree 1/4 sec post
South on true line between sec 2 & 3
1/4 sec 1/4 sec post
Bur Oak 9 S 35 E 53
Aspen 7 S 58 W 37