#751006

10-5-1963 set C/M over 5/8" rod down 15"

1/4 corner 9-10 Kalmar 107-15 O

11-1887 Hunter P422 No 411 $10 F Kingsbell.

Corner in field gone. reset stake from east- center 10 over 1/16 corner. doubling recorded meas of No 119 at 20.18.

- Meas south. 39.94 (2636.) actual 1963 2633.5
- Meas east stakes from center 10 west 15.00 then 22.50 then 2.55 west to corner.


Corner found by McGhie and preserved.

set C/M. over pipe 15" deep.

- Meas south 2633.5 - west 2627.2.
- rod north under fence 907.5.

over

C / M in open field can be found as follows.

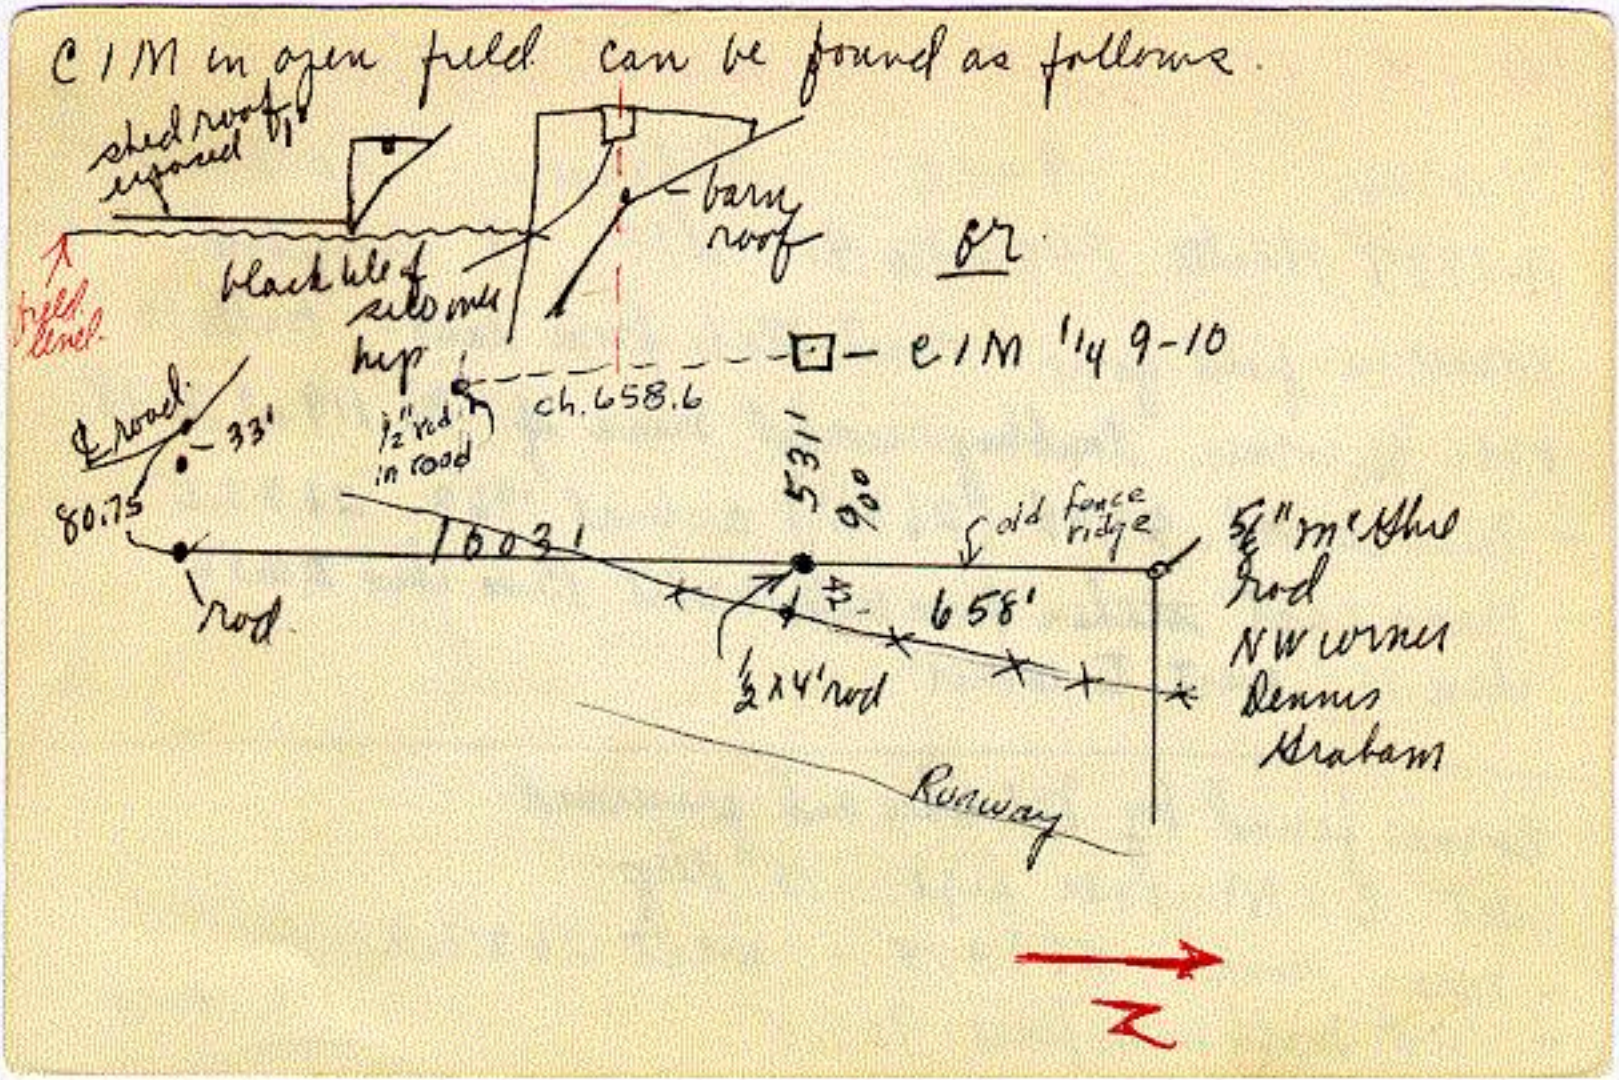

#751006 | 2

Kalmar 1/4 corner 9-10
Coal Mines Karrick 1854
40.00 set 1/4 sec post
Blk. Oak 10 S65 W32
Wh. trunk 20 N50 E50

March, 1864 P.C. Compton Pg. 79 No. 119 Shows 1/4 Corner used for breakdown of NW 1/4 Sec. 10

1/16 East 20.18 chs m & L to Center Sec. 10 found.

1/16 North set m & L (No Measure)