1 6-8-72 set temp iron as corner from west.
9-11-92 set C I M one. 5/8" x 2' rod. #751104 (1)

1/4 corner 11-14 Kalmar 10 9-15

5-1870 Perry P111 no 148. S14 C Finn.
found stake in mound with pits plain.
set stone with stake beside it, renewed mound & pits.
20.05
-1/16 West. set stone and stake marked likely M&L
-1/16 east 39.60 1/2 mile found stake, correctly placed, set a
stone beside it made mound & pits.

1-1882 Hunter P371 no 362 S11. F Foster, C Finn.
found stone in center road.
1/16 N "4" set stake M&L 20.05 (1323.3' one.

1/16 east found stone by Perry to be 5 links too far east, set stake M & L 19.94½ left stone. tonyg
S11-14 1316.37

4-1892 2hoz Fraser P482 No 452 Chas Foster.
found stone by Perry. with stake by side.
1/16 north found stone square on top with cross on top.
on running line from 1/16 stone north of S W 11 a stone 5 x 8 x 25 set this survey in place of stake to above 1/16 cor meas was 20.00¼ 1320.16

oct, 1858 T Hunter Pg. 57 No. 83 shows ¼ Post used for S W ¼ sec 11
Meas. west 40 chs. to Sec. Cor.
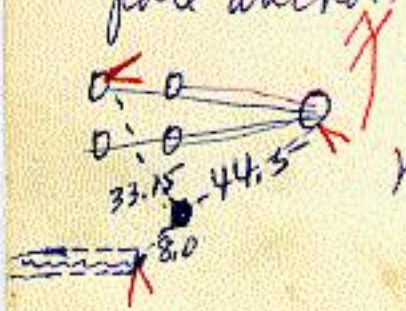
#951104 (2)

Card # 2 1/4 11-14 Kalmar 107-15

6-8-72 Co surv ran & meas line from. 10-11-14-15 east, found 1/16 stone (1870 Perry) 4' deep in east ditch & farm drive - set 1/2" x 4' rod over stone as found. at 1324.87. R 20.07 1324.62 (RP 1/16 stone)

RP. 44.5 NEly to bottle cap on SE end RP 2# 497

33.15 N to punch mark on top of johnnie ball & pole anchor. Northerly anchor & west pair of anchors.



8.0 SW to punch mark in top of rivit lead near top center 18" farm drive culv - eastend.

over for 1/4 cor.

Cont line & meas east and set 5/8" x 2' at
2649.74 on line which came just N of near center
road- west and 3' W center road north.
- checked from east, line & meas from C/M at NE 14.
set by J Kerr 1965 and 1/16 stone west found 1965.
recorded as 5 lks (3 3') east of midway which still is
Corner now 1313.6 NE 14 to 1/16 stone on re-measure
and 2631.5 total or 1317.9 west 1/2 or 2.15 east of Midway
- there is supposedly a square topped stone with cross at 1/16 N.
51.9 NE ly to Corner Nail on N W side PP 21492
17.33 3' W of N to punch mark on top of N end 18" farm field drain tile
19.83 W to single punch mark in S end 18" farm field drain tile.
29.2 10' E of S to Corner post of fence running W- S side road
2.0 South of line of fence running east. RPS 1/4 11-14.

Card # 2 1/4 11-14 Calmar 107-15 (NA) (3)
with 1/16 corner stones found. North of 1/4 11-14 & 10-11-14-15
#751104
9-5-72 corner still 5/8"x 2' rod.
found recorded size 1/16 stone north described by Thos Fraser
with no meas given between by Thos Fraser. (1/16 N of 1/4 11-14)
Hunter gave 20.05 N & L 12 23.3
actual Tap meas 1326.74 as 1/4 11-14 set exact
line from SW 11 over 1/16 stones which also fell within tenth
of SE 11 and 1/16 east line. so 1/4 11-14 cannot be
moved north.
KP's to 1/16 rod N of 1/4 11-14
Hunter claims slab only set N & L 20.05 no stone
35.75 due E to staple on gr wire just below etching # 21478
43.3 SE to nail in R bent cap on top center 4" Cedar brace P.
26.5 W to R bent cap on N side PP #21480 (over


1/16 N of 10-11-14-15 Kalmar. 9-5-72.
found limestone 4 recorded size top set by J Fraser.
1.5' N to west edge corner post of new fence S & E.
8.0' S to center edge (30"±) red or blk oak - with barepipe.
set 4'+ of wavy edge steel fence post on W side up. 16"±
Tap meas east 2639.27 R 2640.16

9-11-72. set C/M on 5/8" x 2 rod. -
- ran aerial for road grading. set center line at center
sec 11 5' east of actual true line between section corners.
staking road from this point both ways to true actual sec corners
- Note this line packed 1/16 stone north of 1/4 11-14 3.37' east
of monuses one 1/16 corner or 32.38 to grave R.P. (over)

Kalmar 1/4 corner 11-11 #751104 14
Gail Waters Kamrick 1854
40.00 Set temp 1/4 steel post
West on true line between sect 11-11 N 89°11' W
40.00 Set 1/4 steel post in mound with
trench, chained stake in mound with
trench, pitts, chained stake & bears Brass
cap's N, E & SW

No bearing trees noticed

12-8-1981 Dug with back hoe from the C.I.M. North for 6½' as follows: →

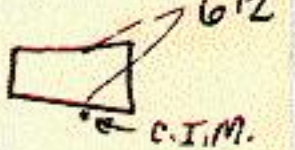

Dug 3½' deep to Clay. Found nothing. Corner in Field drive with Culvert and the whole area had been Cut to Clay. We were digging to Cover T. Hunter's Measure From the Stone Found at the 1116 north in 1972.

(over)

1/16 North - 12-7-1981 Dipped for Iron set over stone found in 1972 and [redacted] didn't get a reading. East and west R.P.s still in place but S.E. 'ly R.P. was gone.