/ 12-9-1981 Set C.I.C. / P2 #751206

1/4 corner 11-12 Kalmar 10 7-15 (1)

6-1870 Perry. P 122 no 157 L12 C Grassley.
used corner to set center section 12
mentioned corner in random line but did not describe.


1-1882 Hunter P 371 no 362 L11 F Poster, C Finn eld
corner gone, in low lands. found small hillock with 3 stake
in it nearly on section line. accepted as corner.
- Meas north set 1/16 stake 19.94 M & L.
- " south 39.96
- 1/16 west set temp stake M & L 19.91 for center SE 1/4 11
common lands on both sides & section line. line.
(over)

Gov't Monument found by 1954
40.00 set ½ steel post [illegible] with trench
pit, charcoal stake [illegible] Orange seed S.W.
S.W.

12-2-1981 Dug from 12' South of Traverse nail south for 3½', west 1' and East 3½' by 4' to clay. Found Nothing

12-8-1981 Dug again this time with backhoe Digging now as follows:

Found Nothing

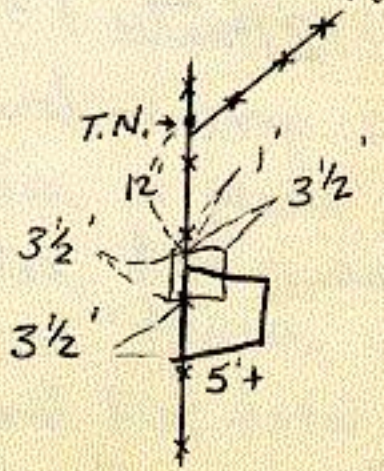

1/4 Corner 11-12 Kalmar Twp 107-15 (2)
#751206

12-9-1981 Set a C.I.C. /P^2 4 lks. North of Midway and at 3.96' West of a straight line between Section Corners as per Hunter's Survey NO 362. T. Hunter's measures to the N-S 1/4 line of section 11 shows 1/4 Corner here 6 lks. = 3.96' west of a straight line by measure. We used this since it places corner under N-S fence. Set survey marker sign and Post .86' West. Corner 11½' South of C.P. to Fences N-S-NE

R.P. C.S.D. west side P.P. # 40017 (up 4')
North 91.99'

1/16 North - 12-2-1981 Tried to dig for this Corner but water kept running into the hole. We dug 1' deep but Could dig no deeper even though Conditions are good. (over)

The point on line between the section corners and midway to a point 4 lks. North of midway between the section Corners. came 11.31' east and 1.58' North of the traverse nail set 1.5' east and .5' north of the corner post to fence N-S-E-W. We tried to dig from this point east and north (to fence)

Gov't Notes: Michael Karrick Deputy Survey (1854)

32.00 uncultivatable Marsh N.E.

40.00 set 1/4 Section Corner in Marsh
set witness quarter corner 3.50 chs. north of this corner. Erected Mound with trench and pitts Charred Stake and osage orange Seeds N.E. & S.W.