X 5-10-1968 set C/M over 1"x12" pipe & trash ①

#751306

1/4 Corner 13-14 Kalmar 107-15.

3-1873 Hunter P217 No 221 L15 J. Fairchild, C Finn.


Caption of 10-29-1879 set W 1/4 14 a stone by using 1/4 13-14 (E 1/4 14) over center both in place.

In 1873 survey. W 1/4 14 in frozen road and not found.

8-1967. J Kerr. run line from NE 14 to SE 14. both C/M's set as near as possible by recorded total mile 5282+ set 3/4 18" rod at 2690' on line.

5-10-1968 J Kerr set C/M as 1/4 corner over 1"x12" pipe.

(over)

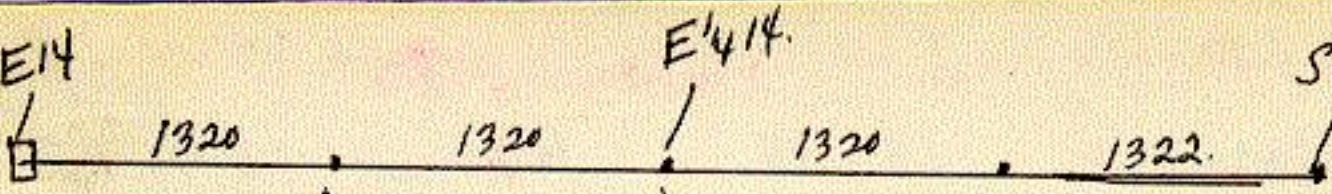

set 3/8" rod 1" east of fence in buck brs 1' north of 11th steel post north of 2 brg cedar posts on south slope of high land.

1968 this rod should be .65' further south

set 3/8 x 14" rod at 2640 on line, came 1' west of N-S fence. 2' north of twin corner posts 2' apart no east west fences.

set C/M 1.3' S.

1320 D set in 1965 as assumed line and 1/16 corner. It came on exact line run and at exactly 39 60 replaced with 1/2" x 2' rod. in line fence west and slightly east of road.

5-1968 set 1/2" rod. 1.6' further south tied to 1/16 line west

1/4 13-14. steel post south .5' just NW of northerly of 2 corner posts of N-S fences.

Note — 10-4-1968 dug at 13-14-23-24 by land found stone surrender Hunter survey as 24. .6 N 6.15 W C.I.M.

Kalmar 1/4 corner - 13+14 #751306 12
Gov't Notes Karnick 1857
40.00 Sec 1/4 Sec. post
Bur Oak 8 S75 W1.0
Jack Oak 12 N65 E 53

3/20/85
~~4 1985~~ V. Tangman found corner 0.5 west of N-S fence, 78' South of fence to east, and 0.5 NE of a steel fence post.

RP: 8d nail in 30" Oak NE 138.92
8d nail in 24" Willow NW 65.67