
#751404

1/4 corner 14-23 Kalmar 107-15

no records of any surveys.

8-1967 JKarr meas. line from SE 14, west about 5' north of fence line total mile to large corner post very evident as section corner from records. 5278.0

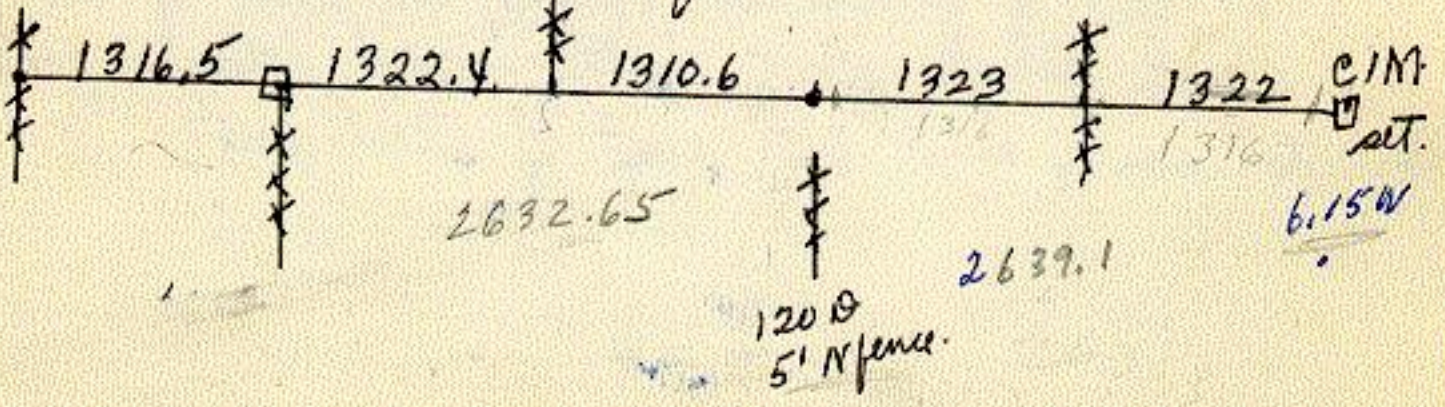

Cont' Metes Karuk 1554
40.00 Set temp 1/4 sect post
West on true line between sect 14+23
40.00 Set 1/4 sect post on mound
with trench & pits, charred stake
and Orange Orange scribe NE & Set,
3/20
1985 V. Fangman. Fd 1/2" pipe 3' South of old E-W fence,
39' East of fence to North, 19' West of old
wood fence post with wood blaze post
to east, and 0.5 east of steel post.