X 5-9-1968 set C/M over ½"x 2' rod #751405 (1)

section corner 14-15-22-23 Kalmar 107-15.


3-1873 Hunter P 217 No 221 S15 J. Fairchild, C Finn found small stake in faint mound with one pit showing claimed set there by J. Fairchild after old stake broke off which was lying on ground near, placing stake in spot where old stake broke off.

– 1/16 west set stake midway (not on line) between stake above and temp point set Midway as meas of S ¼ 15 no line. 19.97½. – ¼ distance of mile.

1967 J Kerr. Measured line from SE 14 established west checking occupation lines etc. total mile to big

Corner post which could be taken as section corner.
- 1/10 west meas to N-S fence west 1316.4 exact record.

+ Meas east 1967 to fences as follows.

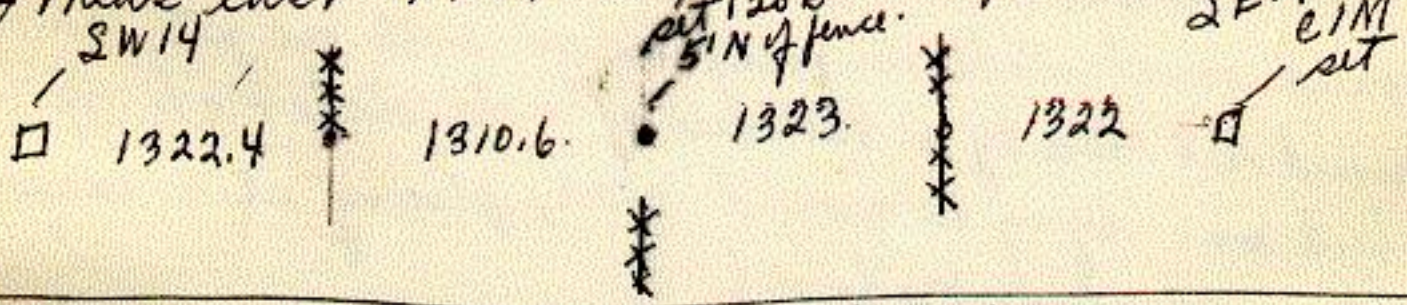

5-8-1968 J Kerr. & I4 Clyde Hoffman.

Run & meas line from NW14 5285.45 to spot just 1'+ north corner post lining fence E & S.
set C/M over 1/2" rod broken clay flower pot & end of barb wire reel centered over rod broken glass midway on mon.
Nail on tree on west side 2' burr oak 19.3 South in Flint

Kalman section corner 14-15-22-23 #751405 | 2

Govt Notes Karrick 1854

80.00 set post for corner to sect. 14-15-22-23

Erected mound with trench, pits, charred stakes, and Osage Orange seeds at each angle