1 4-22-69 set C/M over 1¼x2" pipe (line from south)
6-8-76 Rest CIM up to surface #751505 (1)
section corner 15-16-21-22 Kalmar 10 7-15

5-18 72 Hunter P197 No 207 S21 G Simonson, F Rickert
Corner gone. but on testimony of J C Crawford and others that
original corner lay in line & between 2 certain posts
established corner and set boulder stone as corner.
— 1/16 south set marked stake M&L. 19.96 to stake in mound.
— staked lines from E¼ 21 north and west and south
for fencing - also run line from 1/16 above west setting
stone at Center of NE¼ 21 likely M&L.
— meas west 39.85 to stone set from orig stake this survey

over

3-1873 Hunter P 217 No 221 S 15 Jesse Fairfield.
Cornelius Finn
found boulder P 197.
- Meas east 39.95 to short stake set M & L (corner in old washout.


4-1969 J Kerr B 98 P 49-50.
- found 1/16 corner south - stake with harrow tooth on N Side
set 1/2" x 3' rod south 4 wood stake - flat stone 2 x 12 x 16 on E side.
- set 1/4 21-22 by line over center 20 west & 1320' south
4 1/16 corner which seemed most likely place for 1/4 21-22
- run line north 1320' and set C/M over 1 1/4" x 2' pipe
after digging extensively to water.
- Meas east to 1/4 22-15 set M & L 2634.4
- disc in PP #21965 - E15-16-2.0-18.0 (Code No.) N 173.0
- disc in fence post N 32[illegible]
- fence running east S. 25 ±

#751505 #(2)


SECTION CORNER 15-16-21-22 KALMAR 107-15

5/22/86 FD CIM DOWN 7" HEAD BROKE 1' S OF

℄ E-W RD, CSD IN E SIDE OF C.P. N 32.62

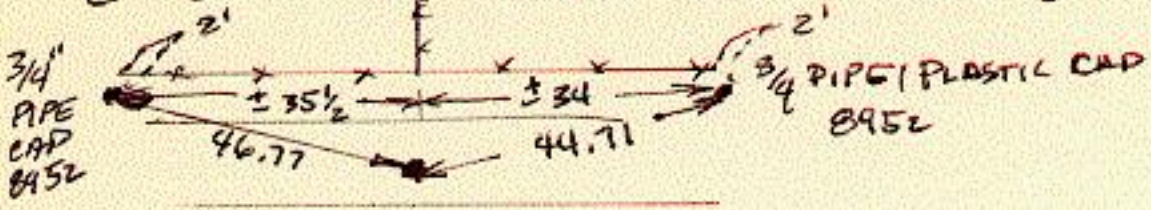

Section Corner 15-16-21-22 Kalmar (3) 107-15
#751505

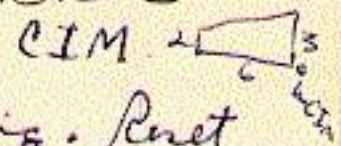6-8-76 Dug 3/2' x 6' NW of pipe over CIM 

Dug 3½' deep to clay. Found nothing. Reset CIM at Kerr location over 3/4" x 15" pipe which is driven into a larger pipe.
Corner falls in line of fence N. and 3½' E of fence S. and ℄ of road E.

R.P.'s Spike in W. side of large Willow SW 38.70'
CSD in E side corner post (behind Willow) SW 50.60'
CSD in pp # 4080 ft NW 122.10
CSD in E side corner post N. 32.73
Punch hole top Center 30" CMP ENE 140.00

Govt Meters Karrick 1854

80.00 St post for corner 11 secs 15-16-21-22

Encircled mound with trench, pits, charred stake and Osage orange seeds at each angle