10-31-1964 set C/M one 1½"x10" pipe with stone on west side below mon. #751804


¼ corner 18-19 Kalmar 107-15

6-1895 H Fraser P 578 No 528 & 19 J Kendall
corner missing, set stone 4x10x18 F Pendergast.
on sec. line and prop. meas.
- meas east 39.66. to stone set in place of stake (now C/M) 2647.56.
- 1/16 west. set stone 5x5x18 on line and prop meas of.
19.83 then 18.71 west to sec. corner.
1308.78 1234.86 or 2543.64

10-1964 J Kerr corner job - found boulder type limestone 4x10x18 south side corner post
set C/M one 1½" x10" pipe with stone on W side below
(mon)

Corner lies 1.5 west fence running north
0.5 south " " E & W.

7-7-1972. replaced broken C/M at W 18-19. 107-15.
Meas east roughly without line, woods, wet, hot, brush
searched quite thoroughly at fence line north & east at 1/16 corner.
(E line Papa Wharton's land in Sec 18) found nothing but land had and
cross lines made N-S hard to determine. did not record actual
meas only that fences within ± 2'

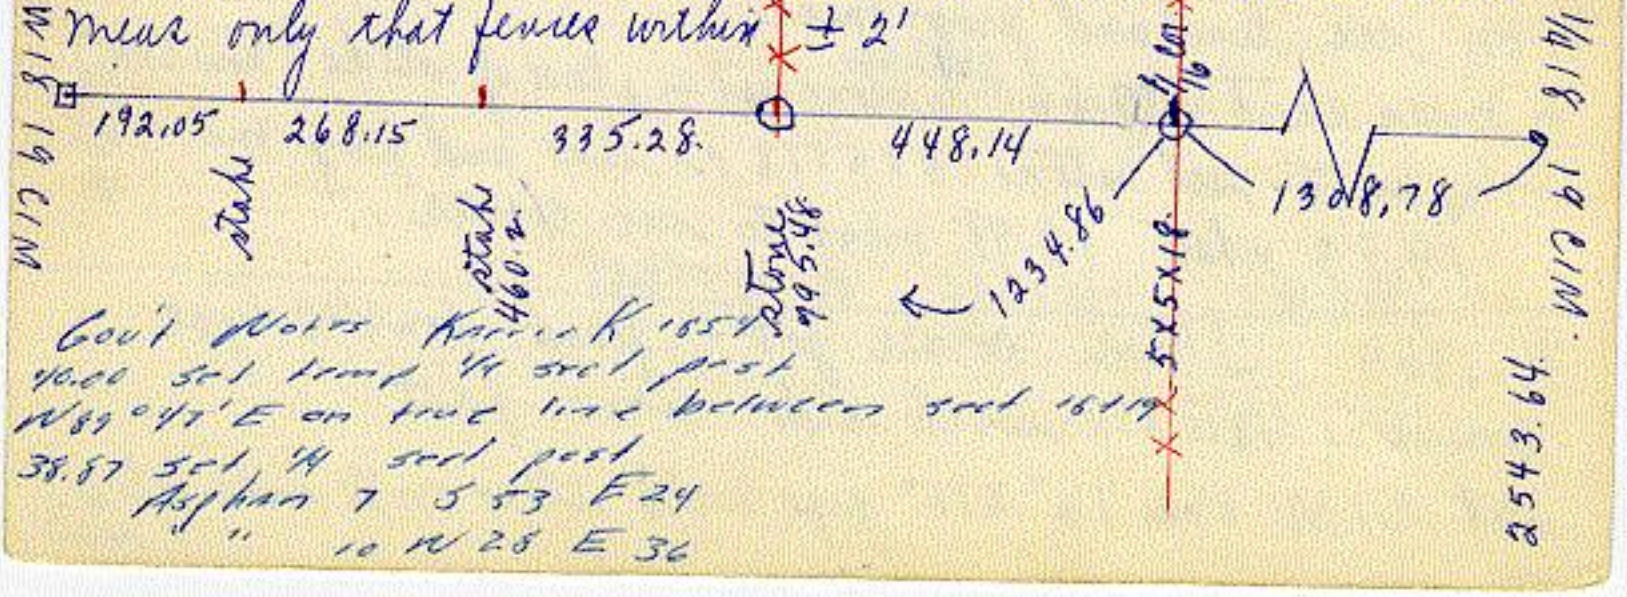

40.00 Sci Iron 1/4 Sec Post
N 89° 47' E on true line between Sec 18 19
38.87 Sci 1/4 Sec post
Asphalt 7 S 53 E 24
" 10 N 28 E 36