/ found stone 4-14-71 set □ iron on E side of L stone ①


#751806 &

1/4 corner West 1/4 18 Kalmar 107-15 Dodge Co.

10-11-12

12-1900 St Fraser P 702 no 617 SW1/4 18 St Allen found stone set as corner by Dodge county surveyor - east - set stake on line and 271 1/4 or 277 1/4 then set stake in center corner ice 406 1/4 witness stake 79 the east. then set boulder stone on line and 608 from above. then set stake 608 to 1/4 corner. 401.28' (6.08 chs

— at point 7.50 495' south above boulder set stone & stakes also stone & stake west 1.02. (66.66' then another 608 to 1/16 stake betw W 1/4 & E 1/4 8. all for lines L.

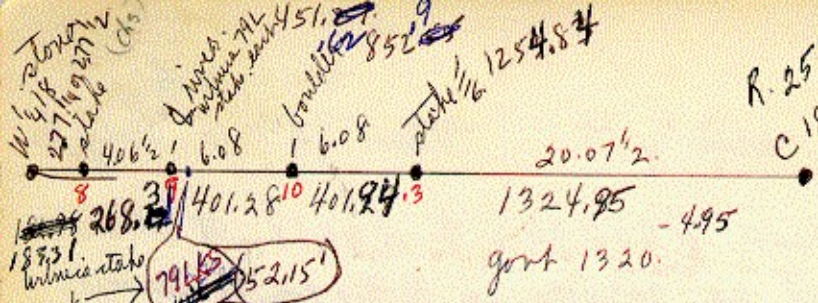

12-16-17-1970 looked for W¼ cor dual ever guess estimated line from fence betw Sta 852.55 and 1253.83 projected it west to fence line found working figured on 28' ℄ south. - set nail at 514.91 on E bank corner.
- set nail at 846.74 about 9' east of corner of fence south. came 28' & fence R 852.55
- set nail at 1247.46 in line ½ fence north R 1253.83 came 23' to cor P.
- set nail at 1947.63 to ℄ 350' south.
- set nail at 2572.53. came 7' W fe N R 2578.79 20' ℄s Douglas Wind & wood.
12-21-70 completed line on 350' ℄ South at Sta 1947.63 and about 1000'± found total to ⅜" rodset M&L cor 17-18 ea. 5194.87 R 5193.38

#751806 (2)

Card #2. W 1/4 18 Kalmar 107-15.
4-14-1971 Co surv. walked around south side of
area of random east 12-16-1970. searched with
probes from 50' north of 00. random south.
found 4"x6" top limestone at least 16" long. .5' east of new
line fence N & S. 3.0' west 4.00 of random and
22.5° north. set 8" boulder on top of limestone with
shaft of ratchet car jack east of stone. .35'
- center ratchet bar east of center stone
- 4" soft elm type tree cut off 3' high with 2 sucker limbs N 10.8'
- 6" " S 6.05'
- center 16" wrinkled bark hackberry 6' E of N 26.05
- " 24" very knarly elm that has V crotch
- (fork E & W) up 10' & 7' E of S 15.0'
- 210' N. of fe. Line west (1976)

over

searched 12-21-70 for boulder at sta 846.74 or now 849.74 R 852.72. found nothing. found large round boulder, slightly pointed side up south about where recorded woodlot stone 495' south would be. ground frozen pretty hard.

4-15-71 found 4"x6"x12"± limestone which pasture was woodlot corner. Came 475.85 south of random R 495.0

- Could not find anything west 1.02 either. may not have been stone

RP to woodlot stone — 2.5' east of woods fence N & S

-12' north of pasture-field fence running easterly.

- center grant 3½ elm in fence south with unique crumpled growth between grant limbs up 15' or so S 29.5'
- grant 3½' elm in pasture center SSE 92.0'
- point center large boulder above ground NW ly 5.0'

Gov't Notes Karnick 1854

#751806 (3)

West 1/4 18 Kalmar 107-15

1/0.00 See [illegible]

Elm 24 West 21 links

Elm 12 5 70. East 13 links