/ 6-2-80 Drove 5/8" rod in New Grade from R.P.s (1)

#751809

1/4 corner Center 18 Kalmar 107-15

10-1900 Jr Fraser P702 no 614 SW1/4 18 N. allen.

found stake by corner of fence

- 1/16 west drone stake ~~on~~ on Line 20.07 1/2 line south.

- pat. stake and bonedierstone west of above 1/16 corner. 6.08 (401.28') with stone & stake south of boneder. 7.50 ('495' then stone & stake east of this corner. 1.00 ckd 67.32

4-1905 Robt Fraser P82B SE1/4 18 N Moehnke & atty. co

found short post standing with limestone with boneder beneath it, ~~in line of fence~~ north & south. (over)

Void L Orion

– 1/16 east used on set corner. M & L 19.78 1/4 = 1305.65

– set stake south of above 1/16 corner 12.46 9/16 (822.76').

– set corner east " " 3.95 13/40 (260.9')

for line south to corner 260.9' east of center SE 1/4 18.

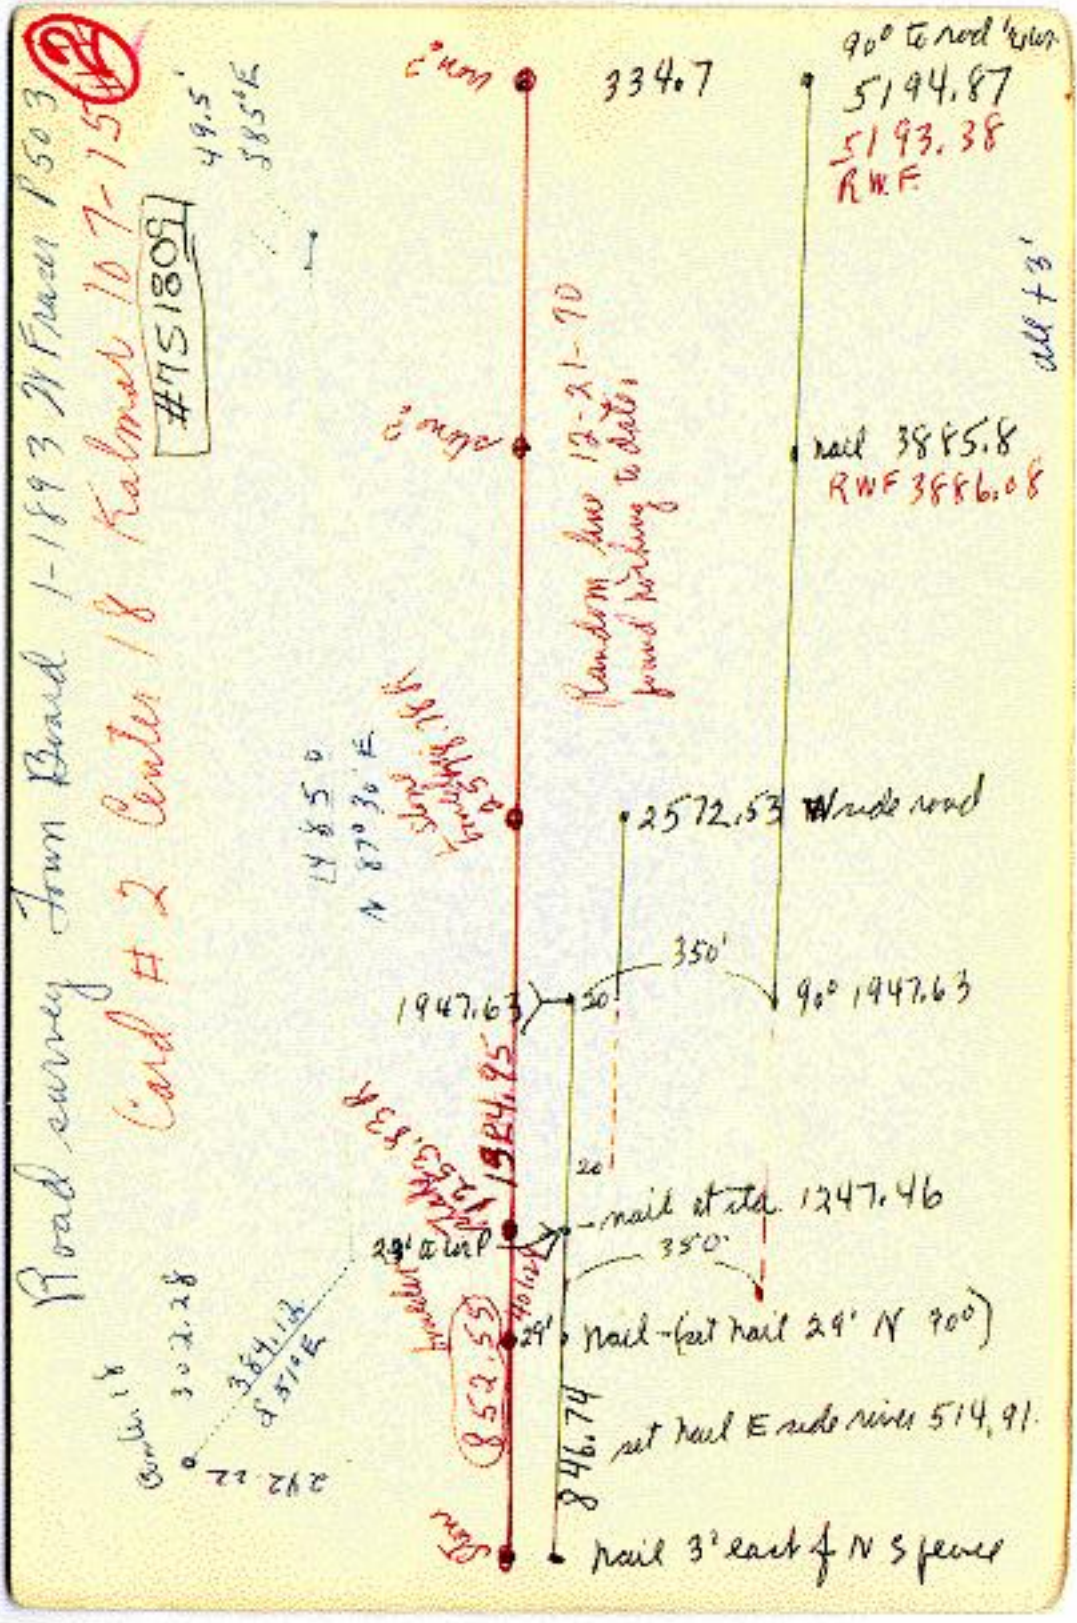
1-1893 W Fraser P 503 No 473 S 18 Town board.

found stake set by Thos Fraser 1890 unrecorded survey

in place stake still in place from early day sub-division.

– 1/16 east found stake M & L placed 1890 survey. 19.80 1/4 1307.03

Note: No county knowledge of corners. – line & mens from west only proof of line for replacements. See W 1/4 18.


Road survey from Bend 1-1893 N Fraser 1503
Card # 2 Center 18 Kalmath 16 7-15
#715180
49.5'
S85°E
334.7
90° to road 'ries
5194.87
5193.38
RWF
add +3'
nail 3845.8
RWF 3886.08
Random line 12-21-70
found building to date
N 85°
N 87°30' E
2572.53 W side road
350'
1947.63
90° 1947.63
20
1324.95
nail at std. 1247.46
29' also nail
350'
29' nail - (set nail 29' N 90°)
852.55
846.74
set nail E side ries 514.91
nail 3' east of N spruce
3821.28
S 1°E
2192.22

4-8-71 Co surv. run random aerial direct between S¼ 18 and N¼ 18.
S¼. CIM in place of orig W Fraser limestone by fence corner. - N¼ set in
10-1965 by JKerr by govt proportions
(govt 19.00 - 20 - 20 - 20 = 1254' - 1320' - 1320' - 1320') set 1965
1256.17 - 1322.89. 3 times.
this aerial wood corne (corrected) 16' west of Highum pipe.
or about 2567.58 east of actual stone at W¼ 18. which
is impossible R 2578.78
- line from west wood bring stone or stake recorded. about 6'
west and .47' north of Highum pipe.
Highum pipe 16' East of direct N-S ¼ line
" " 8.25 N of direct E-W ¼ line.
Random 22.5 S at W¼ 18 11.85 S at Highum 15.3 N at M&L ¼ 17-18.
15.3 + 22.5 = 37.8 ½ = 18.9 22.5 - 11.85 = 10.65 corrects random N of High
18.9 - 10.65 = 8.25 that Highum wood goes to be on direct line E W

12-16 & 21 1970. ran & meas line from random point which finally came 22.5 south and 3.0' east of stone found 4-14-71.
- set nail at 849.74 (Corrected 8') which came 475.85 north of woodlot stone found recorded as 495.0 S of stone at woodlot stone. or 19.15 south of recorded boulder woodlot corner which could not be found in ground, boulder on top of ground. R852.55
- offset 350' south for use as sight from sta 1950.63 (corrected 3' also offset south 350' at 1950.63 also offset S 25° E to mica bldg. to get to center 18. set nails at 2575.93 and 2615.83 (Corrected 3' this line fell 31.85 S highum pipe and sta pipe 2583.58 corrected.
- proj line east on 350' offset S of random found 1/16 fence at. #751809
3888.8 corrected. (point east of witness tree) R 3886.08.
- cont to 5194.87 R 5193.38 which fell 334.7 S of 1/4 rod 90° to Highum corner now 8.25 north of corrected E-W 1/4 line.
- 1/4 iron east of center 18 fell 649.3 east of Highum and 2.65 N of random line or 1.6 north of true direct line as run.

(3)

1-8-1973 summary of work done to date on Center 18.

- Data on all 1/4 corners set to date.
  West 1/4 - found stone found and used by W Fraser in P 702. 12-1900.
  South 1/4 - found stone set on line & prop. meas W Fraser in P 578 6-1895.
  North 1/4 - CIM set by JKen exact good prop meas 10-1964.
  East 1/4 - rod set M&L 2627.3 4-1971.

4-8-71. ran and corrected aerial direct from S 1/4 18 to point within 100' ± of CIM at N 1/4 18 line fell 2.85 east of N 1/4 18 and 14.6 west of Highum pipe conduit, corrected would place exact 1/4 line at 14.6 + 1.42 or 16.0 west of Highum pipe to be direct line.

- as Highum pipe came. 2583.58 east of stone at W 1/4 18 W Fraser R. 2518.78 or 4.8 east of record meas Highum corner could easily go west to record.
- E-W 1/4 line forecard

Center 18 (4)

Data furnished by Keith Ewers (1976)
R.P.s to Possible Highway pipe at Cen 18

#751809

1½" pipe

16.0 S.S.W. to ℄ C.R.
58.7 N to Fence post on N side driveway
51.75 N.W. to W. end 42" C.M.P.

5-16-77
3-22-77 Set a 120d spike at intersecting ¼ line by e.t.c. Corner came in NW'ly bound lane of Co. Rd. 5. Corner 3½ NE of ℄ on curve

R.P.s Top Center of Hose Valve at the NW corner of house SW ~~104.07~~ 102.08

NE'ly corner of concrete slab ~~in~~ front of step at NE corner of house NW ~~155.86~~ 153.11

Spike with ribbon in RP # 22046 W ~~118.31~~ 115.57

3-28-77 Removed possible Highway pipe found ~~and 8.16 East of 120d set~~ 7.59' North ← OK

6-2-1978 (1980 Lemon. BK, Page 52) Center 18 : Reset a 5/8" x 18" rod from the reference in the new crushed rock road

Additional RP's Square punch hole in E end 36" CMP North 48.60