1 4-22-69 set C I Mon on ½" x 2' rod. Many stone wire, tones
#752206 #1

¼ corner 21-22 Kalmar 107-15

5-1872 Hunter P197 No 207 S21 L Simonson, F Rickert found mound with remains of stake in center.

- 1/16 north run & staked line set stake M & L 19.96 due north
- Meas south 39.76 to stone found N 50° E
- 1/16 west run & staked E-W ¼ line - set stake M & L 20.05
- 1/16 center NE ¼ 21 set stone 4 x 8 x 16 on line & midway on E W 1/16 line.

---

5-1900 Robt Fraser P680 No 605 S27 C Christianson found 3 pointed stakes 2" thick 1' south corner post of fence and old post remains just east of stake also found one)


2 stones just north of stake one on top of other.
this stake came in an apparent mound & pits plainly
visible. drove new stake and put stones on north side.
- Meas south 39.90

---

4-22-69 J Kerr. B 98 P 49-50.
found 1/16 corner north stake with barrow tooth south. drove
1/2" x 3' rod just south of wood stake. set on W 1/4 21 run aerial
over center 21 as set. this line came 3' north of fence each
at 1/4 21-22 making 1320 as meas to 1/16 north R 1317.36
but better than 1323 to fence east where no definite corner found.
this put 1/16 north M & L 1320' To C/M set as NW 22.
— set C/M as 1/4 21-22 over 1/2" x 2' rod in cluster of small
boulders, wire & 2 pieces of bone. - this corner slightly east
of fence north and 3' north main fence line east - doubt 8" or more
on East & South of Mons found Nothing June 1976

1/4 Corner 21-22 Kalman 107-15 #2
#752206

6-8-76 Dug 4' N-S by 5' E-W by 3½' dep.

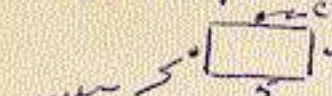


. Found nothing. Dug using T.H. 1872 measure less usual overrun from 1/16 W and 1/16 N.

Set Hole Knock 5/8"ϕ-5' in mound with brass plug, chiseled stake & orange orange stake NE & SW