/ 6/12/86 set c1c/p2

#752304 (1)

1/4 corner. 23-26. Kalmar 107-15

5-1872 Hunter P 204 No 212 & 26 J Hogans, J Stafford.
found fence post in center mound with pits plain.
- 1/10 east 19.87 (1311.4) set stake.
- 1/10 west 19.83 1/2 (1309.1) set stake.
- meas south 39.73 to stake set inter lines.

1967 J Kerr. meas section line see 23-24-25-26.

1972
~~Steel~~ pipe set by McChie + Betts ~~12/29/72 witness~~ and on line

Govt Meas Kerr & K 1954
NO.00 set temp 1/4 steel post
W.S.1 on true line Govt ---- steel 2312c V 9°11'
NO.00 set 1/4 steel post in mound with trench, pits
cleared stake and Orange Orange ribbon W.E.1 Sec

1/4 COR 23-26 KALMAR

6/14/86 DUG FROM T.N. (1ST ONE) FOR 2' E, 4' WEST, 2½ NORTH & 3' S. TRAV NAIL .8 N. OF E-W FENCE, FD BETTS PIPE & CAPE .4 W & 1.1 N. OF T.N. FD POST HOLE DEEP IN CLAY WITH PIECES OF WIRE DOWN THE HOLE. 1.7 S. & 4.0 W. OF T.N. LINE FROM 5 1/4 COR OVER CENTER 26 FALLS 3.2 WEST OF T.N. ON LINE & PRORATED LOCATION IS 1.53 N. & .78 W.

1/16 W OF 1/4 COR 23-26 KALMAR

DUG FROM T.N. FOR 5' NORTH & 4½' WEST BY 1½' DEEP TO CLAY FD NOTHING (SEE CARD #2)

1/16 E OF 1/4 COR 23-26 KALMAR

DUG AROUND C.P. & 3' W, 2' NORTH & 4' SOUTH IN SLOUGH, FD WIRE N-S-E-W TO -2" DEEP, WATER SEEPING IN HOLE, FD STUB OF POST (AXE MARK ON TOP) POSSIBLE STAKE ON N. SIDE, PULLED 10" OF STAKE BUT COULDN'T GET ANY MORE, STAKE .4 E & .4 S OF C.P. & OLD POST .4 E & .8 SOUTH


1/16 W OF 1/4 COR 23-26 KALMAR #752304 (2)

6/9/86 LOOKING FOR OLD C.P. MENTIONED BY ROBERT FRASER AS BEING 1/2' NORTH OF THE STAKE, C.P. IS BRACED BY A POST 2' W. & A POST 2' W. & A LONG PIPE DRIVEN BESIDE IT AND WIRED TO IT. FD' NO OTHER POST MARKS IN THE HOLE, THE C.P. SEEMS TO BE THE OLDEST, THE STUB BEING ENTIRELY ROTTED AWAY, AND ONLY A MARK REMAINING. THE MARK IS .7 W AN. 8 NORTH OF THE T.N.

1/4 COR. 23-26 (2)

6/12/86 DUG FROM POSTMARK FD HERE FOR 6' SO. & 6' E. FD MARK OF A SMALLER POST APPROX 1.4' SO. & .2 E OF 1ST POST, SET CIC/P² AS CORNER E-W ON LINE FROM THE S 1/4 COR 26 OVER THE CEN 26 & N-S DIRECTLY EAST OF 1ST POST STUB FD. CORNER 1.12 EAST OF POST. LOCATION FITS T. HUNTER'S OVERRUN (8 I'/½ MILE) TO THE CENTER OF SECTION 26 AND IS BOTH THE OLD E-W FENCE LINE HERE & IS ON LINE FROM THE NE COR 26 OVER THE POST STUB FD AT THE 1/4 E, FD ABOUT 6" OF WOOD STANDING 2.05 SO. & 2.30 E. OF CORNER AS SET. WOOD WAS JUST UNDER SOD & COULD HAVE BEEN TIP OF STAKE BUT TOO DECAYED TO IDENTIFY & VERY SHALLOW

1/16 W OF 1/4 COR 23-26 DUG ON SOUTH & EAST SIDE OF 1/16 C.P. AS FOLLOWS

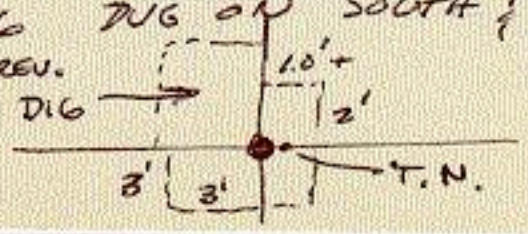

6/9/86

OVER ↓