8-17-67 set C/M over 2" x 20" pipe (1)
6-12-72 found true corner reset C/M. #752405

section corner 23-24-25-26 Kalmar 107-15.

5-1872 Hunter P204 no 212 L26 J Duffin, J Hogane. found a foot of old stake in center road. set stone. 2x8x15 in place with small stake by it's side.


-1/16 west set stake 19.87 N&L to fence post in mound. (1311.4)

8-1967 J Kerr mens 1 mile north, 1 mile east, 1½ mile west ½ mile south dug 2 days 4' wide 5' dep 8' long. run line NE 23° south. run 115' to south line from west on fence lines. finally set C/M in line fence remains west and very near center road.

(over)

Bottle cap east side power pole LSE 258.6
" " North " " " W 36.4
corner Lee & road and in line old fence west
below in line west between 23 and 26 record actual

N. 11° W. 3.5 Found 6-72

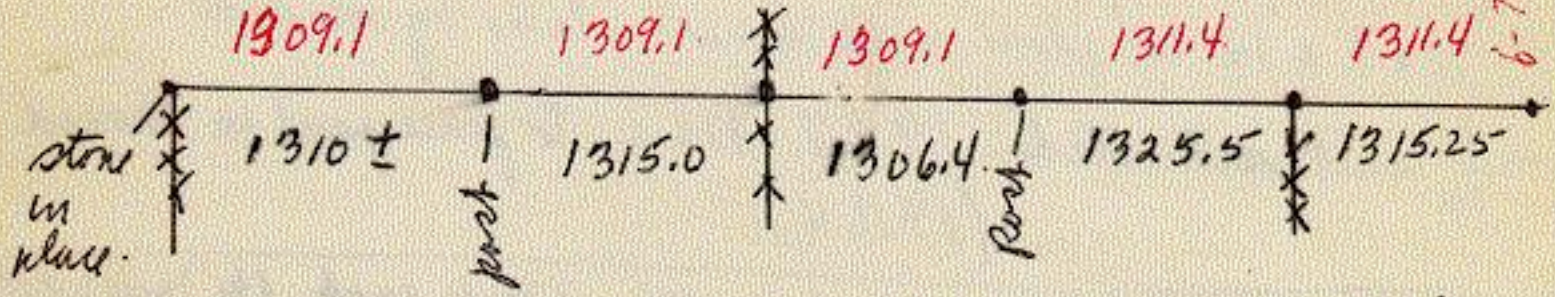

Mease North to 1/4 cor ~~set M & L~~ ~~2638.5~~ 5273.0 found 10" 1968 stone
" east to C1M 5262.2
" west to corner post.

April, 1863 P.C. Compton pg. 72 No. 103 shows sec. corner
(See Survey For Interior breakdown sec 25) No mens.

#752405 (2)

Card No 2 on section corner 23-24-25-26 Kalmas 107-3
found unrecorded survey of Sec 24 Hunter 5-1880
in old book in court house P 111 no 358
stated stone set 4x6x18
- meas north to 1/4 stone 40.15 (2649.9)

- random meas 1967 from center intes at W 1/4 24 2657.
indicating until actual meas from above 1/4 south at C 1/4
set may be 6 or 8' too far south, also aerial line from
SE cor 24 over corner just at E 1/4 24 proven OK nearly for
E & W that of line straight corner stoned be way north 24.3
at E 1/4 24 Maybe east also or theres crook meet in line
from north. -

10-1970 Co surv meas w/bnt line from C1M at 1/4 23-24 south to C1M as ret. 2653.6 Hunter plat 40.15 2649.9
Hunter. written. 79.95 total, 39.76 N½ or 40.19 2651.54
6-9-72 ran direct aerial over 3 lath - NW 24 - 1/16 south - 1/4 23-24 all lined up almost perfect - proj line to C1M at SW 24.
- line fell 16.3 west of C1M.
- meas 1/4 23-24 by Zap east to 1331.55 rod 1331.65.
meas 1/4 23-24 by Zap east to center. 2633.1

6-12-72. Co surv. dug with tractor found recorded. 2"x7" top L stone very vertical in dark soil, no stones other.

Lee Card #3.

Card # 3 23-24-25-26 Kalmar 107-15 (3)

6-12-72 Co surv. dug with tractor found. #752405
2" x 7" top Limestone set 5-1872. by Hunter.
- corner 5.5' deep. 4.1 North, .3' east of CIM in place.
- corner 16.6 east of direct line 13-14. 23-24 over 1/4 23-24
or 1/4 23-24. 8.3 west of direct line section corners.
- removed CIM set. 8-1967. & pipe below & reset same
over stone found. set 18" flaring metal plate over stone.
- meas N to 1/4 23-24 found 2649.5 R 2649.9
- meas E to 1/4 24-25 CIM set rough to meas 2644±
corner center road 4' N of fence E & W.

over RPs

36.92 W to rusty bottle cap on N side PP# 22204.
orig C.M. 1967 36.4

32.15 NW To punched brass in N end 2' farm drive curb

31.44 SW same S end.

36.78 SE To punched brass in S end 2' farm drive curb

31.7 NE same. N end.

Govt Works Knock 1554

80.00 Set post for corner to mark 23-24-25-26
Ground mound w. rb trench, p. pts, chard stake
& Orange Orange seals at each angle

CARD #4 23-24-25-26 KALMAR 107-15 (4)

8-22-96 CHDSET 1" sq pipe w/cap in ℄ down 0.5'

Spk & Large Disk in PP SE 69.82' #752405