Removed CTM Set Pipe

10-31-1964 ~~set CTM~~ over 5/8" x 14" rod.
11-4-73 found Steel rod below CTM ~~set~~ Removed CTM set 1¼ x 5' pipe as corner (1)

¼ Corner Center 26 Kalmar 107-15

Cor. 4-15-75 #752609

5-1872 Hunter P204 No 212 S26. Hogans. Duffin set stake marked at inters. right lines.

– 1/16 east set stake M&L 19.81 1320.46 N 89° 20 W.

– 1/16 west set stake M&L 20.02½ 1321.65 to corner shown by John Duffin as corner. stake nearly new did not believe it to be true W¼ 26 but accepted it at this time

– mens north 39.73 S 10' W 2622.18

5-1885 Hunter P396 No 386 S26 J Graham etal. found stake set P204. set stone with horseshoe below it. as witness

over)

1315.7.1

1/16 west set large boulder. M & L 19.93½ to W ¼ 26.
established this survey correctly.

66 86 10 FD POINTED BOULDER 9"X11"X14" DUG WELL INTO CLAY DOWN 1FT 1" PIPE STANDING 6 WEST

7-1956 J Kerr. with aid of Forrest Wahlton Caterpillar found stone & horseshoe as described.
-found 1/16 boulder west - reset both corners 7-25-1956 B63P69

10-1964 J Kerr set C/M over rod after grade in for some 8 years dug fill. No ½" pipe with 1½" pipe around it ar 7-25-56 B63P69.
½" rod in fence line south (set 1956). 50
corner lies in ℄ road in line fence south, no fence north.
found ½" rod easily 50' to ℄ road. dug with post hole digger near 5' got no dip of any kind. abandoned & set in line fence south and at 50' from rod found.

Card # 2. Center 26. Kalmar. 107-15 #752609 (2)
5-7-73 research concerning doubt of some corners in area.
5-21-1872 Hunter P 204 No 212 S 26. J Hogans, J Duffin.
at "5" set stake marked 1/4 S as center of section at
the inters of lines B-F and H-D.
-16 west. set stake not marked at M & L. 20.02 1/2.
1321.65' with doubts as to its accuracy (of W¼ cor. 26)
-16 east set marked stake M & L and drove it low.
M & L 19.81. (1307.46 to stone found in center
of road.
W 1/4 26 stake found uncertain stake. used as found
6/6/86 1/16 WEST OF CENTER 26 KALMAR: PD POINTED BOULDER
9" X 11" X 14" + DUG WELL INTO CLAY DOWN 1' THERE IS A 1"
PIPE STANDING 6 WEST

5-2-1885 Hunter P396 no. 386 (Center 26)
found stake as set by me in survey P204 no 212 at intersection of 1/4 lines and now set a stone in its place with horse shoe under bottom as a witness.
We also set stakes on line from "D" to "E" and from "1" to "2" for fencing
-16 W set new 1/16 "2" "set large boulder stone M & L between "D" and "3." 19.93½. (1315.71
-16 on S line W½ 26 "1" set quary stone 2x6x20 M & L 19.95 (1316.7).

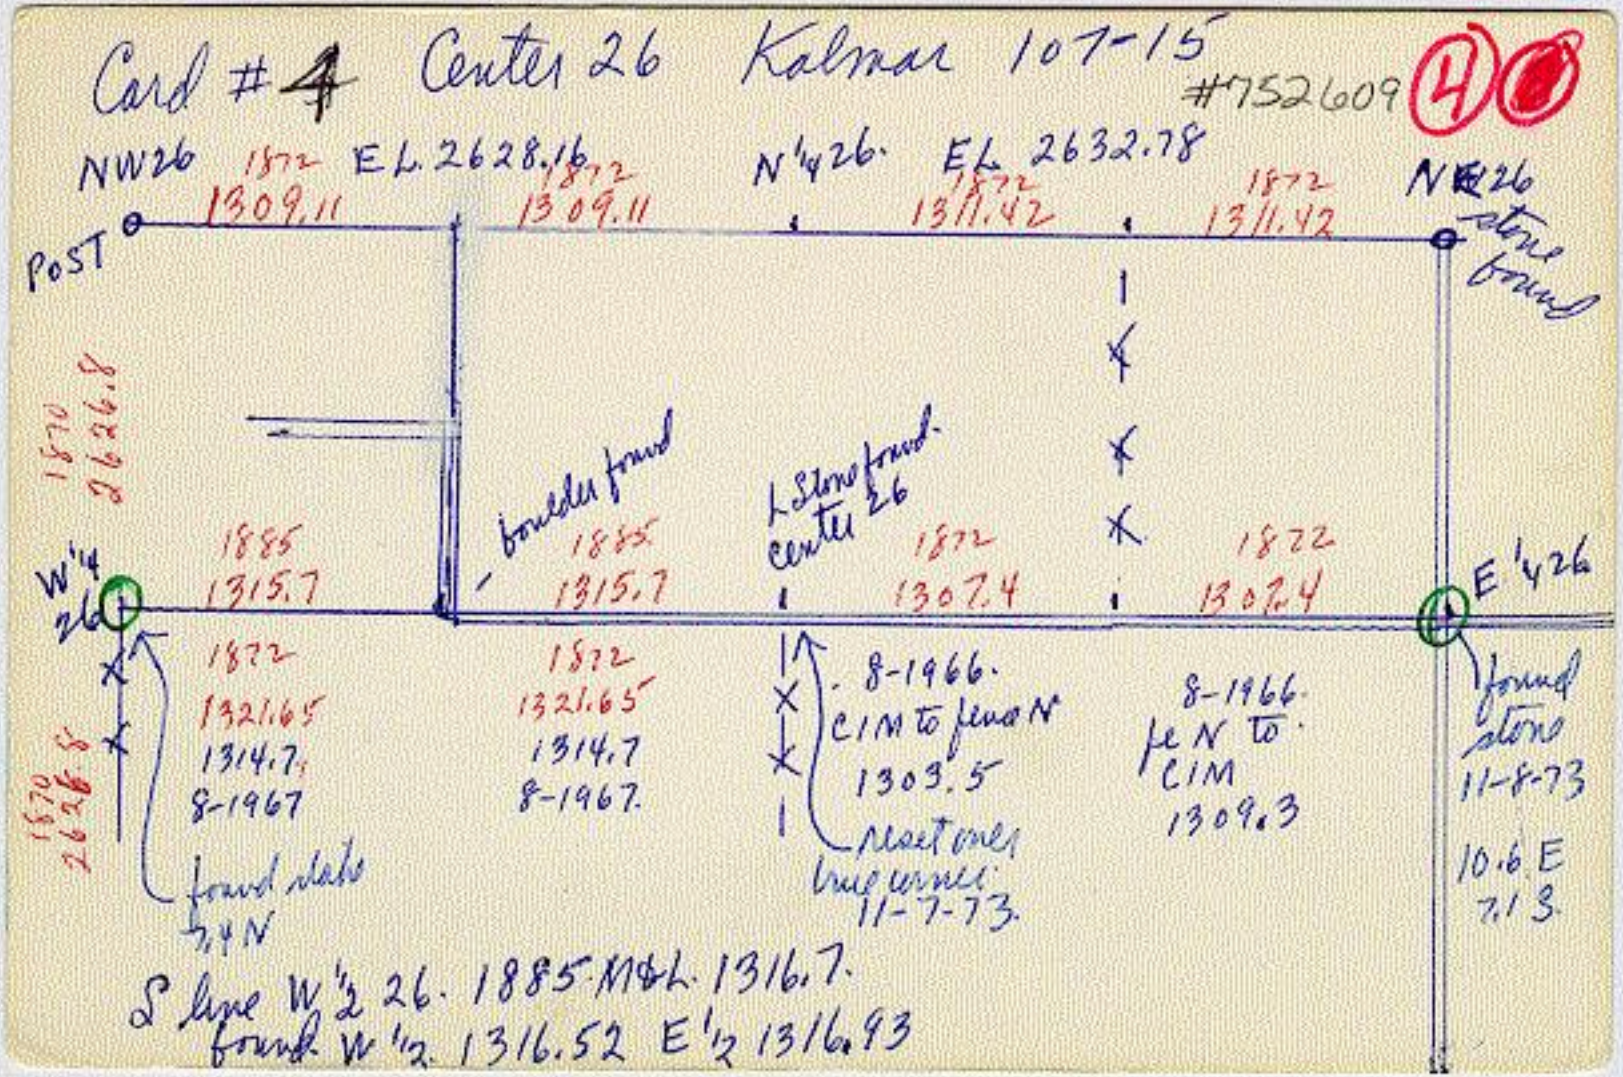
Card # 3 Center 26 Kalmar 106-15. #752609 (3)

11-7-1973 dug on S side C/M. with buck hoe.
found. 3/4" iron with horseshoe arround it with piece
of limestone on E & W sides likely pipe below.
very near or slightly north of C/M.
set 5' piece of 1 1/4" pipe with well cylinder (broken)
at bottom. directly over rod.

50' S to 1/2" rod up 2" on old fence row.

36.1 N to ground wire on W side trans PP# 40081.
Corner corner eye line about .5' west line & west
side power poles from behind North pole.

Note 1/4 25-26 found ?.? S. 1/4 26-27. found stake ?.? North.
Set C/M there. Set C/M there


Card #4 Center 26 Kalmar 107-15
#752609
NW26 1872 EL. 2628.16
1309.11
1872
1309.11
N'426. EL 2632.78
1872
1311.42
1872
1311.42
NE26
stone found
POST
1870
2626.8
W'4
26
1885
1315.7
boulder found
1885
1315.7
Stone found.
center 26
1872
1307.4
1872
1307.4
E'426
1872
1321.65
1314.7
8-1967
found date
7,4 N
1872
1321.65
1314.7
8-1967.
8-1966.
CIM to fence N
1303.5
reset over
true corner
11-7-73.
8-1966.
fence N to
CIM
1309.3
found
stone
11-8-73
10.6 E
7.1 S.
1870
2628.8
S line W'2 26. 1885 MEL. 1316.7.
found W'2. 1316.52 E'2 1316.93