X #752905 (1)

section corner 29-30-31-32 Kalmar 10-7-15

.5-1871 Perry P 162 no 185 L 29-30-31-32.

found orig post in mound set stone 4x14x23

renewed mound placed old slab on top of stone.

-1/16 set stone. north 19.97 1/2 M & L.

-1/16 south set stone. 2x14x28 M & L 20.00 or 19.99 1/8 and

witness stone 50 lks north. -1/16 west set stone 3x16x26 pointed 20.00 M & L

6-1871 Perry P 168 no 186. L 31 re-survey.

used corner as set P 162.

1/16 south pulled stone P 162 set. 2x14x28 on new line

(over)

M & L 19.84 1/2 with witness stone 2X14X17. 50 lks. South.
- 1/10 west used corner P162. stone set 3 X 16 X 26. pointed.
likely set M & L 20.00.

10-1939 J Kerr B16 P40.
stone at fence corner.
- meas north to M & L set. 2631.

5-1-1968 J Kerr & Mann Hwy Dept crew. accepted and.
found 1 1/4" pipe up 4' in ground. over 4' just west of corner post all
points south in line said post. dug & probed entire area found many
piece limestone laying near pipe flat. run & meas line south. found
rod or bolt in Blacktop at 1309.28. radius to ℄ railroad at 1619.45.
Center line passing 2619.4. on pushing line to SE cor 31 (C/M
missed mon on west side. 8.5 ± west of mon. (Hwy crew)

#752905 (2)


Card # 2. section corner 29-30-31-32. Kalmar 107-15
Co H D B 320 1966 found 1/2" rod set by McGhie
set C I M on 1/16 corner in place of rod - 1/16 between NE 31 & 1/4 31-32.

Hub N 63.79 Hub S 47.8.
Hub SE 52.56 Meas east to SE school. 1318.33. (a rod.)
Meas east 2637.84 To rod in Blacktop.

---

suggested line must to search for 1/16 stone set M & L no meas given. as entire mile straight, stone if found would unlock to entire project. (if corner at NE 31 as set is correct) the 1/16 south (C I M by Co over McGhee rod) if judged by projection of line by state highway crew may be 1/4 of 8.5 or 2.1' too far W.

There is no railroad tie to this corner but tie to
1/4 31-32 ∅ 995.5 or 999.5 (seems 999.5 correct.)

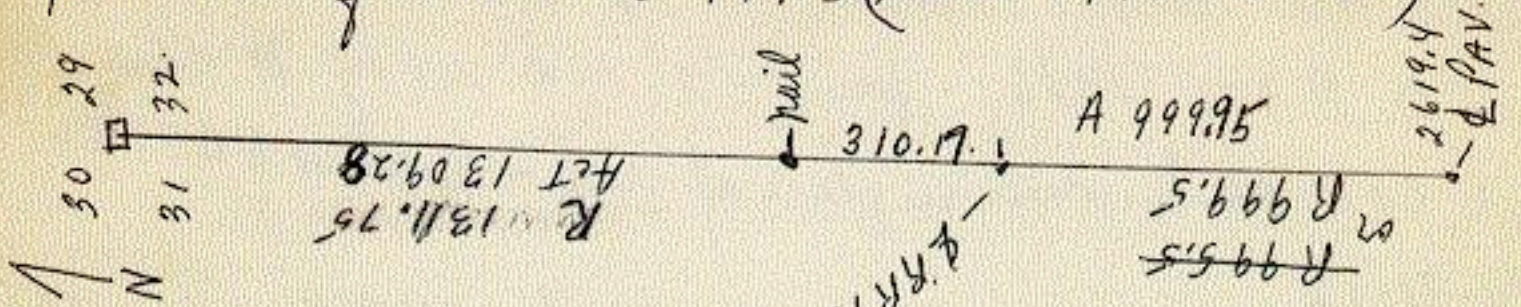

assuming that 1309.28 is true corner with 310.17 ∅ ∅ ½
wood lane 1309.28-310.17 or 999.11 and ac Center pavement
is 2619.4 half 1309.7, all Meas fit quite well

6-18-70 Co surv. ran & meas line from pipe now used as
corner North to 19-20-29-30 - found proper corner at 1/4 29-30.
placing pipe as set. Not quite in proper place. 1/4 29-30 set M & L
when done with cross in place. Pipe would go .45' North and
1.36' East


