
1 8-14-90 set CIM over orig stone and 3/4" pipe ①
section corner. west 30-31 Kalmar 107-15
east Dodge county. #753005
5-1871 Perry P 162 no 185 S 29-30-31-32.
found stone monument in fence line.

6-1871 Perry P 168 no 186 S 31 re-survey.
found stone as sec. cor. on town line.
-1/10 south set stone 4x8x18. total 40.07.
Meas. this line 3 times took mean meas.
-1/16 center NW 1/4 31 set stone 5 1/2 x 6 x 14 inters lines.
(Compton 1863 states stone 5 1/2 x 5 1/2 x 14 P71.
(over)

Compton's 1863 P 71 says
1/16 east. 4 x 6 x 15 1/2. No mear.

Hunters R R Notes 1496.5 south to ℄ R R tracks

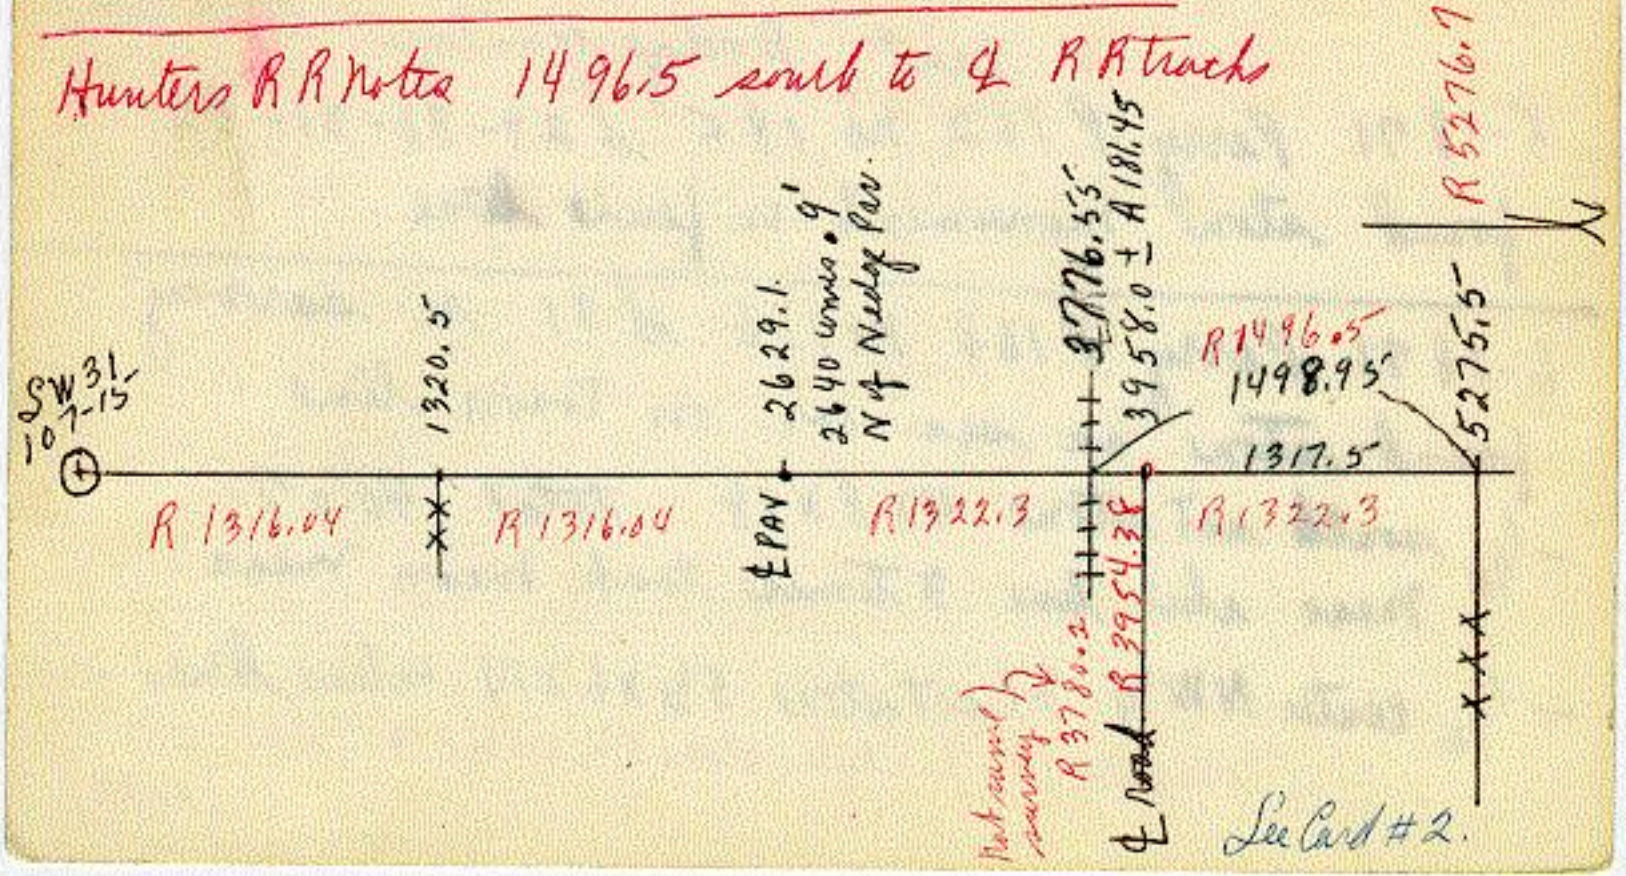

#753005

Card #2 W 20-31 Kalmar 107-15. (2)

6-23-70 Meas from NE 31 west - found stone D. County
at 1/16 at 1316.57, found fence north a good fence at 2632.6. set stake
& old steel post south & huge corner post which lines main
fences E, W, N, cont to fence south at 1/16 west of N 1/4 31 found
exact wires 4 1/2' south & cor post 1317.0, cont to & road.
set 1/2" rod in line fence east at 1248.72 record meas.
- Meas south to rod set at 1/16. 1320.48 witnessed.
- Meas rod to exact & RR on line 1498.39 witnessed.
- Meas rod to nail in & pav set on computed 1 mile line.
which is 3.8' east & direct mile line (this nail coned to changed.)
8-18 1/16 south now 1/2 x 3' rod at 1320.67 & railroad 1497.13.
& 16" 1/2" pipe

over.

8-14-70 used tractor found corner easily a very large sandy limestone 30" x 12" x 10" Triangular shaped about 2" dep
- removed stone dug hole deeper placed 3/4" x 14" pipe and 30" stone on rod with CIM stone 5" dep.
- corner 1.3 south and .67 west of iron (removed)
- pepsi cap in unmarked power pole SW side SSE 96.6.
- pepsi cap " " " " NW " NNE 97.9.
- hard nail on South side 12" oak cor post leadroad dip E 36.0
- pepsi cap in creo cor post Telephone W 60.6
- corner in center road about 1.3' south main fence east


