1 — 8-18-1970 set lead slug in pavement as corner.
#753106

1/4 corner West 1/4 31 Kalmar 107-15 (1)

Dodge county line.

5-1863 Compton P71 No 101 S 31
set stone. or used corner to set Center 31

---

5-1871 Perry P162 No 185 29-30-31-32
found part of old stake with old faint pits near.
run west sec line, mile short 6 links.
corner found. 5 3/4 (3.81) lks east of direct line and
10 (6.6) lks south of midway.
set stone 8 x 10 x 23 in place of stake.

(over)

6-1873 Perry P 168 No 186 & 31 resurvey found stone P162. checked this by aver of Mr C. B.? who claims his fence was run from orig corner also Mr Lehmans for his fence west found first post set which proved stone still correct.

see sketch W 30-31. - Meas SW 31 to fence east at W 30-31 found & Par at 2629.1., & RR at 3776.55, & road east at 3958.0 and fence east at 5275.5 Record 40 rec at 2632.08 fence at 5276.68

8-18-70 Co surv after meas of 1968 accepted by state electronic and elaborate and detailed meas & line in 1970 set lead slug as corner.

see card # 2.

#753106

Card # 2 W 1/4 31 Kalmar 107-15 (2)

E 1/4 36. Mantorville twsp, Dcounty 106-15.

Meas west line 31 in 1968 noting meas to ℄ pav from twsp cor (SW cor 31). 2629. (state electronic 2629.27 then 5275.5 to line ℄ fence east at NW cor. 31.


- after finding NW 31 and running aerial line set W 1/4 31 a lead slug in concrete pavement by proportionate meas from Perry survey.

- slug set 3.8' east ℄ direct line at 2642.64' (2641.34) from NW 31 which came 2.92' north ℄ center line pavement

- meas south now 2632.02 to twsp corner.

- meas lead slug to 1/2" pipe on ℄ of railroad

(OVER

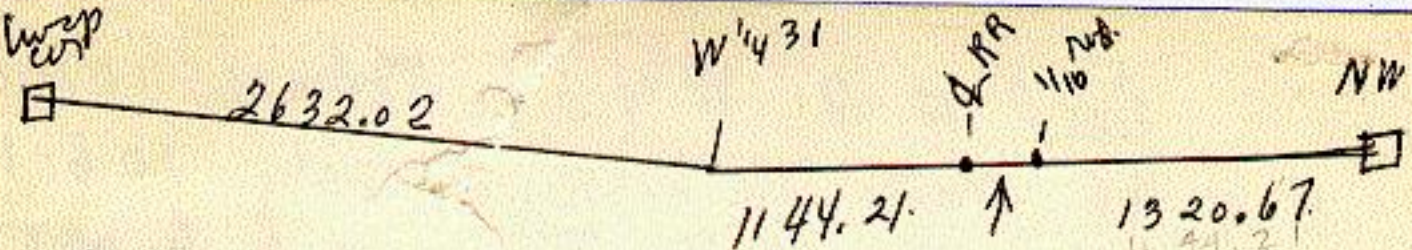


RP W¼ 31.

1.82' west to forming point
2.92 south to ℄ pavement

176.46
1497.13.

100.07 NNW to ⊙ in south end new 18" field culvert
31.38 to spiketail cross ⊢ cut in N end large 36" road culv.

final RP to ½" x 16' pipe set in Center RR on line ahead. NE

Cross cut in NE corner of north RR abutment NW 32.3
" SE " south " SW 33.0.

3/11/80 Found lead slug in pavement (set 1970) under blacktop patch and checked 1970 RP's correct.

Govt Notes, Kanick, 1854 W 1/4 31 107-15 #753106 (3)

40.00 Set post and drove 5" chained stake for quarter section post. Built mound. Planted SE. Osage Orange trees, NE. Apple trees.

1/16 corner between stone found at NW corner 31. Calmar on county line and lead slug set in pavement at 2642.64 from NW 31 and 3.8' W of direct line as recorded. 2.92' N of center pavement (record. stone 4x8x14 set M&L. 1322.3 by Perry. 6-1871 #753106 F

8-18-70 did not dig for corner road filled 8'± in Cattail bog. area but corner could still be there.

- set 1/2" rod on section line as set up and on line of 1/16 stones east enters this line which is near or exact M&L 1328.67± pipe set in center RR. 176.46 S of this 1/16 rod. (See W1/4 31)

49.65 NW lg to cross cut in N end of conc hdwl. West side

50.09 NE lg to cross cut in east side road Culv hdwl.

97.35 NE to pepsi cap in brace post of fence east.