
1 8-17-1972. set temp corner and referenced from south,
9-9-1973 set 3/4 length CM over RR spike. Wabash
section corner north 2-3 Viola 10T-12 county.
#823505 (1)

10-1889 2 Fraser P436 No 423 L 2 Lexington - Johnson.
found boulder placed and used by Hunter set years before.
and set on spot of orig govt. stake.
1/16 east 2 corners found here. 1 Hunters, 1 other surveyor.
no remarks as to line south which was used.

5-1890 T Fraser P441 No 427 L 3 R Johnston.
found stone P436 also tested S W B T stump.
- Meas south 40.01 1/2 then 39.87 2641 then 2631.4
- Meas West 39.89 1/4 to temp point for line south.
2632.9

8-17-72. ran electronic traverse to corner from South.

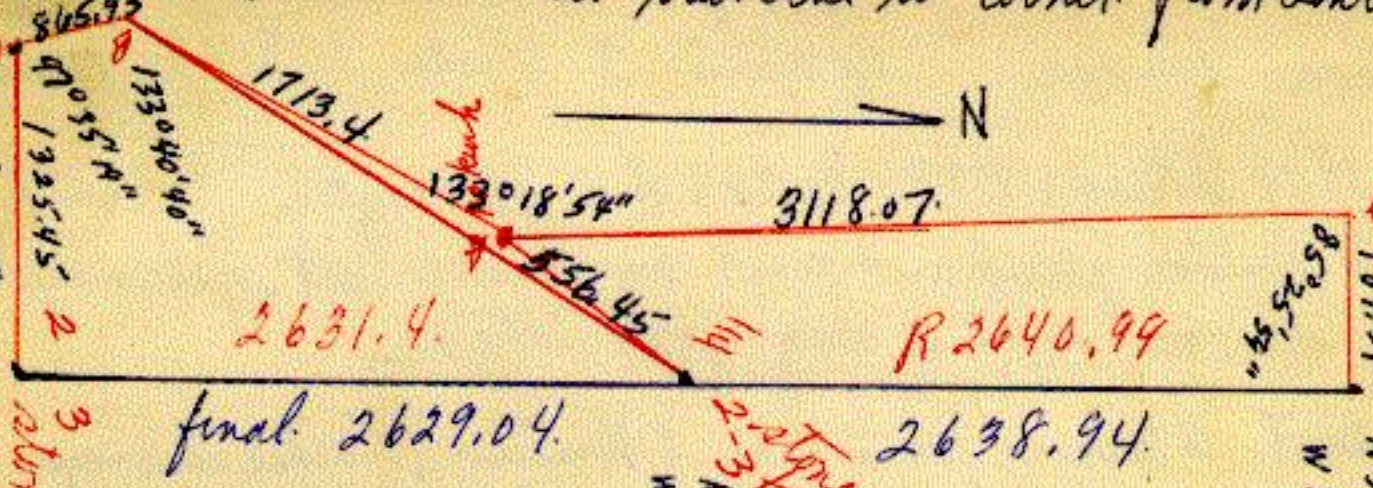

set temp final corner and referenced (by nail).
Complete traverse checked by W.H and Kaeder survey Co.
Will set final corner later, bedrock down 8 inches.
41.75 N to nail in power pole.
40.64 SW to nail in tele pole.
corner near south edge traveled road.

Viola north 2-3 #823505 | 2

7-7-73 found RP on pole and Kansas mon. 1 ott .15 N & 5 set 3/4 length CIM on bed rock. Very hard, with R.R spike driven into bed limestone

additional RP

64.57 SE to head of large mail on sw side of corner post of short fence south measured step. Head of mail at road level

Cent Notes Comes 1953

Set section post, 80 chains from east 5280' built mound with trench and pits 8 links south.

Bur Oak 10" S 37 E 37½ links