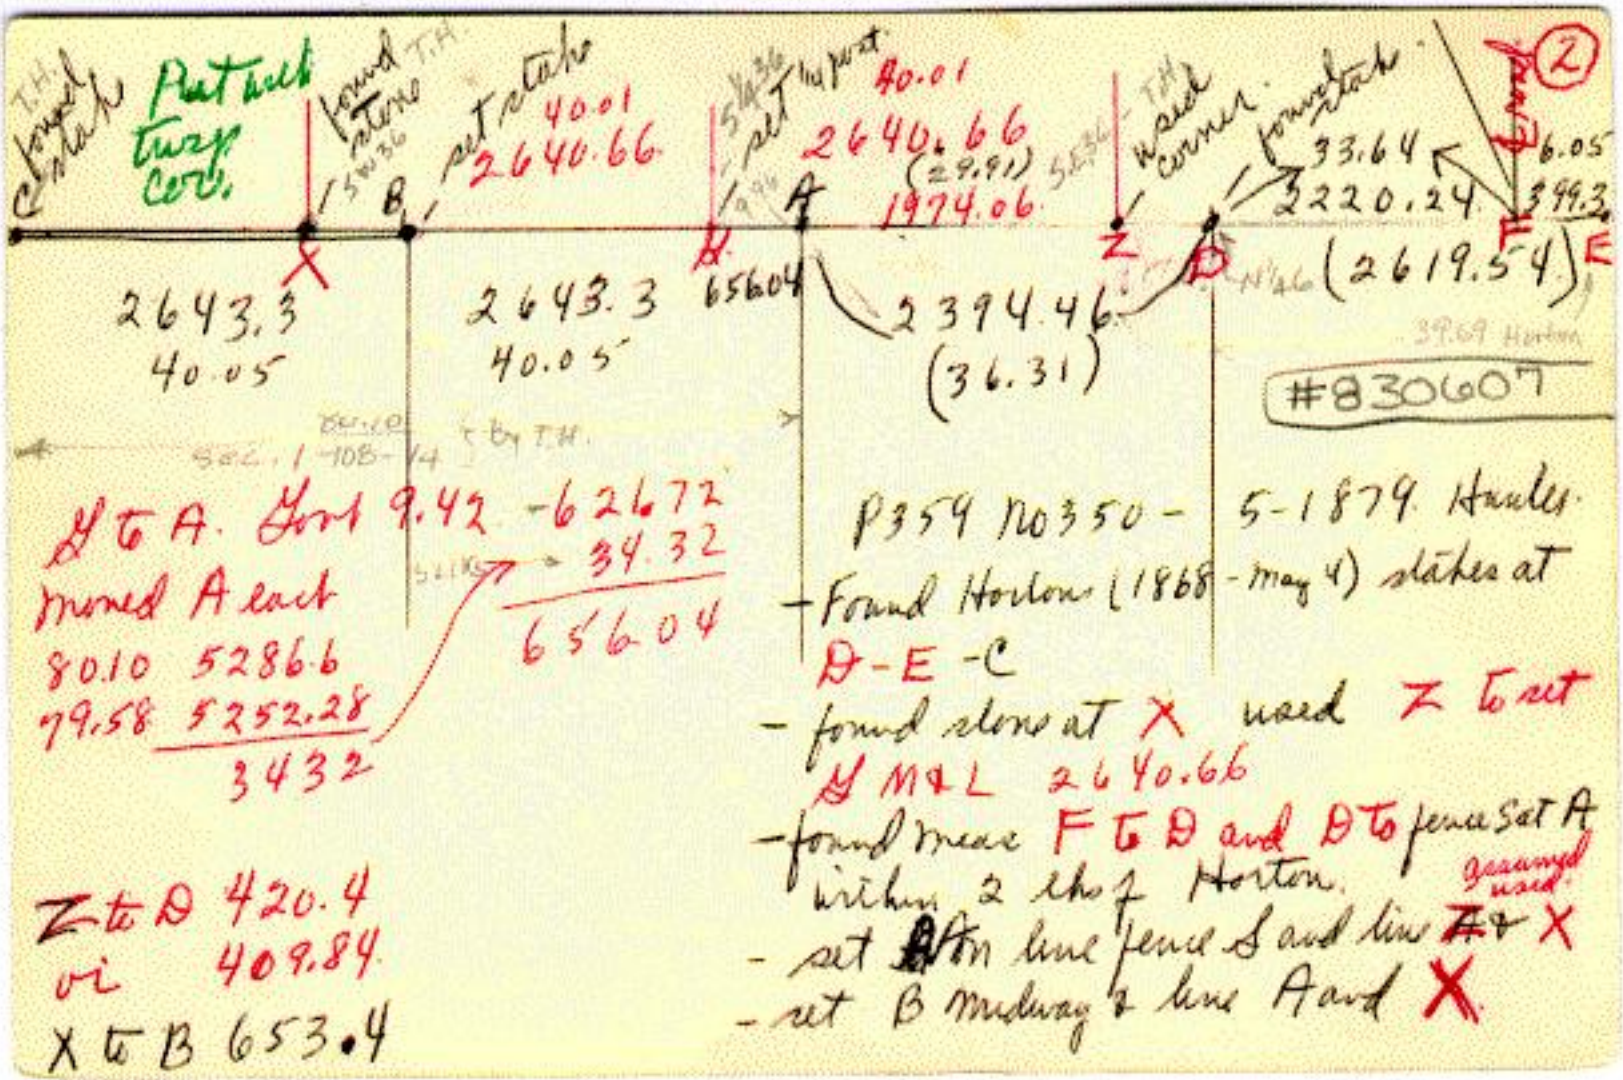
7-6-1964 set C/M on top engraved twsp corner
6-1-76 visited corner + found marked as pl'd
Section corner NW cor. 6 Farm 10813 (1)
NE " 1 Arono 108-14
#830607
and Wabasha county
1878 Hunter to set twsp corner as ordered by law
- corner gone. found NW cor 1 and SW cor 36 109-14.
which line west of N 1/4 1. (See N'46 108-13)
- meas 80.02 from SW 36 east - set S 1/4 36 M & L 40.01
- then set twsp corner on line 9.42 east of S 1/4 36. =621.72
making meas accross N line Sec 1 79.58 - 54 lks short

5-1899 Hunter P 359 no 350 L1 Pomray, Stedeman
on verbal evidence of where corner orig stood when over

Horton surveyed town line road ca. 1868, done extensive work.
- found. N¼ & 108-13 set by Horton when NE6 was standing
- NE6 to ℄ old lake city road 6.05 chs then 33.64 to stake
Horton set as N¼ 6 or 39.69. then 36.31 to twp corner
Then standing 1839 Meas from ℄ road to N¼ stake found and
then to where settlers said twp cor stood in line fence
south. and certain distance to rail fence corner (stub standing)
corner then mound & pits. Meas came within 2 links.
- removed monument and placed at this point making
meas accrase N line ℄ 1 80.10 instead of 79.58, within
2 links of point meas, N line sec 1. mound, 52 lks east
9.42 + 52 & 9.96 west to ℄ ¼ 36.

7-1964. found corner. in line fence south and 3' N of
east-west fence., no road now, no fence north.
- steel fence posts on N & S sides C/M on top mon.


T.H. found stake
Patrick Twp Cor.
found stone T.H.
B
set stake 40.01 2640.66
A
set 1/4 post 40.01 2640.66 (29.91) 1974.06
T.H. found corner
found stake
33.64 2220.24
6.05 399.3
F
E
(2619.54)
39.69 Horton
#830607
X
Z
D
2643.3 40.05
2643.3 40.05
65604
2394.46 (36.31)
Sec. 1 T08-R4
by T.H.
Y to A. Govt 9.42 -62672
Mound A east
80.10 5286.6
79.58 5252.28
3432
34.32
65604
P359 N0350 - 5-1879 Hanley
- Found Horton (1868 - May 4) stakes at D-E-C
- found stone at X used Z to set Y M&L 2640.66
- found mear F to D and D to fence set A within 2 chs of Horton.
- set B on line fence S and line A and X
Z to D 420.4
vi 409.84
X to B 653.4

1946 MHD found 8"x8"x24" limestone with hole in center 4' north of corner post (book # 142)

4-25-95 FD CIM WITH TOP 2 SECTIONS BROKEN OFF. WE DUG DOWN TO THE LOWER HALF WHICH IS OK. IT IS STILL LOCATED BETWEEN TWO STEEL POSTS. THERE IS NO LONGER A FENCE DIRECTLY SOUTH OF THE CORNER.

#830607 (3)

Section Corner			
	NW Cor. 6	Farmington	108-13
	NE " 1	Oronoco	108-14

Wabasha County.

Set by John Ball 10-1853
79.33 Intersected 2d standard Parallel 942 links East of Quarter section post on South boundary of Section 36 Township 109 North Range 14 West & built mound with trench per instructions at center drove charred stake.