/ ~~6-2-76 Set CTA~~ 8/18/92 Set 1" SQ PIPE/CAP AFTER ROAD GRADING (1)

#830704

1/4 Corner 7-18 Farm. 108-13.

6-1879 Hunter P361 No 352 S18 A Buckholly. C Bluhm.

Corner gone, in road, niner any B tree.

no evidence or knowledge. N-S fence set by guess as acknowledged by owners

- meas. NE cor 18, found, To 4 way fence corner at NW 18 76.75 10 lks short govt meas.

- set stone in center road. at 36.80 from west 39.95 from east, no mentions of bone. used only to set center Sec 18.

(over)

6-1878. Hunter unrecorded survey ne 340 1/2. S18. Meas line 76.79. set corner at 36.85 from west. 4 way fences.

- corner came 42 lks east of fence lines N & S

True line 36.85 Set a chared gr. post in mound of Earth & Sod made trench & pits and planted Osage Orange seed on East & West Sides of Trench.

5-24-76 Dug 2'/4' x 9' x 11' deep. Area beneath oldest road (8' deep) was dug 5' x 5' to clay from 1' N of ℄ south and covering N. 4' of our diggings. Found nothing.




6-2-76 Set CIM over 1 1/4" x 22" pipe 1/2' N & C.R. #12 1 1/2' West of fences N and S. Set monument at intersection of N. line Sec. 18 and the N-S 1/4 line 18. R.P. CSD in W. side C.P. N 54.63, CSD in pp# 34990 SW 76.65

#830704 (2)

1/4 Cor. 7-18, Farmington, 108-13

7-16-84, 1/4 Cor 7-18: Took reference before road graded.

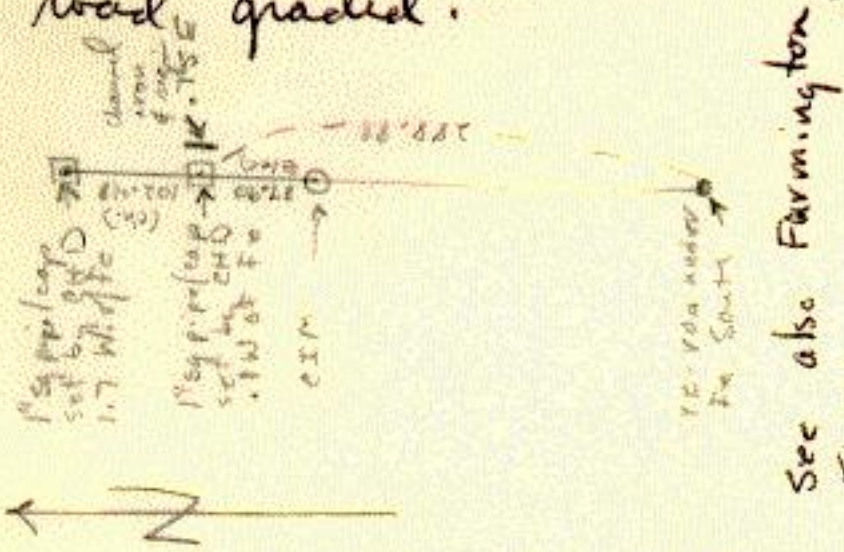

7-17-92 set Concrete No. 1 from R of F Pipe in Black Top CR #12

8/18/92 County Surveyor Set 1" SQ PIPE/CAP AT LOCATION OF CIM SET IN 1976 BEFORE ROAD GRADING. THE CORNER FALLS IN ℄ OF C.R. #12 IN LINE OF FENCES NORTH - SOUTH

RP's CIC IP² IN FENCE LINE NORTH 87.90'

CSD IN PP # 34990 SW 76.10'

/ ~~6-2-76 Set CTA~~ 8/18/92 Set 1" SQ PIPE/CAP AFTER ROAD GRADING (1)

#830704

1/4 Corner 7-18 Farm. 108-13.

6-1879 Hunter P361 No 352 S18 A Buckholly. C Bluhm.

Corner gone, in road, niner any B tree.

no evidence or knowledge. N-S fence set by guess as acknowledged by owners

- meas. NE cor 18, found, To 4 way fence corner at NW 18 76.75 10 lks short govt meas.

- set stone in center road. at 36.80 from west 39.95 from east, no mentions of bone. used only to set center Sec 18.

(over)

6-1878. Hunter unrecorded survey ne 340 1/2. S18. Meas line 76.79. set corner at 36.85 from west. 4 way fences.

- corner came 42 lks east of fence lines N & S

True line 36.85 Set a chared gr. post in mound of Earth & Sod made trench & pits and planted Osage Orange seed on East & West Sides of Trench.

5-24-76 Dug 2'/4' x 9' x 11' deep. Area beneath oldest road (8' deep) was dug 5' x 5' to clay from 1' N of ℄ south and covering N. 4' of our diggings. Found nothing.




6-2-76 Set CIM over 1 1/4" x 22" pipe 1/2' N & C.R. #12 1 1/2' West of fences N and S. Set monument at intersection of N. line Sec. 18 and the N-S 1/4 line 18. R.P. CSD in W. side C.P. N 54.63, CSD in pp# 34990 SW 76.65

#830704 (2)

1/4 Cor. 7-18, Farmington, 108-13

7-16-84, 1/4 Cor 7-18: Took reference before road graded.

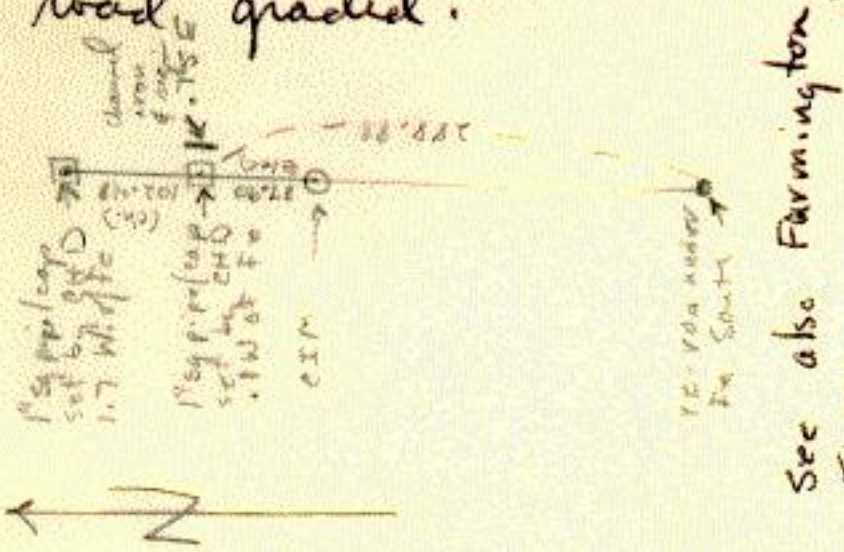

7-17-92 set Concrete No. 1 from R of F Pipe in Black Top CR #12

8/18/92 County Surveyor Set 1" SQ PIPE/CAP AT LOCATION OF CIM SET IN 1976 BEFORE ROAD GRADING. THE CORNER FALLS IN ℄ OF C.R. #12 IN LINE OF FENCES NORTH - SOUTH

RP's CIC IP² IN FENCE LINE NORTH 87.90'

CSD IN PP # 34990 SW 76.10'