9-20-79 CIA #831104 ①

1/4 corner. 11-14 Farm. 108-13
Set by William Yerby 5-1854
9-1894 H Fraser P 552 no 509 S14 Lampbrecht
found stone set M & L in unrecorded survey 1893.
used to set center section

7-21-70 Co surv re tie of corners on 247 prior to re-surface
good fences N & S - good fill 5'± at ℄ no record of state or
County using of finding corners
found 5/8" rod at ℄ slightly east of fences N & S .8'±
- ~~Nail~~ pop cap in SW side power pole # 35209. NW 114.8
- punch mark in culv apron clamp lug, field drive each end SE 57.75
- same in west end SSE 38.5

over)

- brass cap in tile pole south 71.0

3.9.98 Set a gr Sec post in mound of Earth & Sod, deposited charcoal Made trench & pitts, planted Osage Orange Seed N & S.

Co. H.D. field BK 44 p. 16 Apr. 8, 1925

Topog. along Road Sta. 569 +36 ¼ line fences N. & S.

Apparently No Stone found or located


meas. East 2630'±
west 2630'±

9-19-1979 We dug with the backhoe over the M&L point which came in & T.H. 247 and slightly East of fence North and South. At 5½' deep and beneath the same crushed rock road that was over the stone found at NW 14 we found two limestones (one 2x12x10 and on 2x12x9 standing (N-S) side-by-side .25 South and .75' East of midway. The stone where

¼ Corner 11-14 Farmington 108-13 (2)

standing over the Easterly wall of an old stone culvert as shown:

#831104

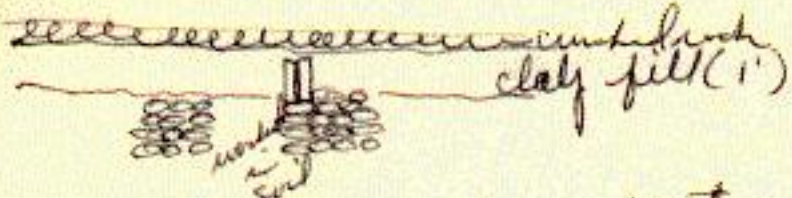

and would have had to have been set after the culvert was filled over. We removed the stone and dug out part of the culvert. There was a 5/8" x 9" iron (tied out in 1970) which pulled out when the blocktop was pulled out by the backhoe which we had dipped before digging, the dip being beneath our M&L nail

9-20-1979 Set a CIM over a ½" iron over the location of the stone found last .25 North of the center of the stones to be on line between the section corners. The corner .75 East of midway. The corner is in ℄ T.H.247, 1' East of the fence N & 2'E of Fence So.

RP's:

1983

Pop Cap in SW side power pole # 35209 NW 115.30 OK

Punch mark in lug at top East end C.M.P. in Field drive South SE 57.23 OK

Pop Cap in East side telephone pole S. 71.08 OK