
831409

1/4 corner. Center 14. Farm 10 8-13.

9-1894 W Fraser P 552 No 509 S 14 K Lamprecht. planted "square block" as center section at intersection of 1/4 lines

- corner came 2 1/2 links west of corner post of fence east.

7-27-83, Center 14 ☉ Went to dig at intersection of lines from CHD iron at W 1/4 Cr 14 to t.n. @ E 1/4 Cr 14 (set in line for E & W) and CIM at N 1/4 14 to c.p. @ S 1/4 14. Pt came in ~~the~~ 7.26 West and 1.68 N of t.n. and in the center of a 3 corner post fence corner and on West side of 2' diameter chunk of concrete where a 4th wood C.P. had stood.

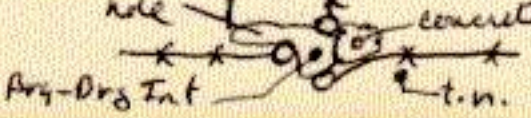

Dug out area

between posts and West on North side of the fence West by 1½' deep to clay. Found nothing and very little chance for anything to survive.