8-4-83 CTC/P2 #832606 (1)

1/4 corner 26-27 Farm 108-13

no records. 10-1946 JKerr B32P28 set corner.

3/8" pipe with 3/4" x 3' riser. set M&L.

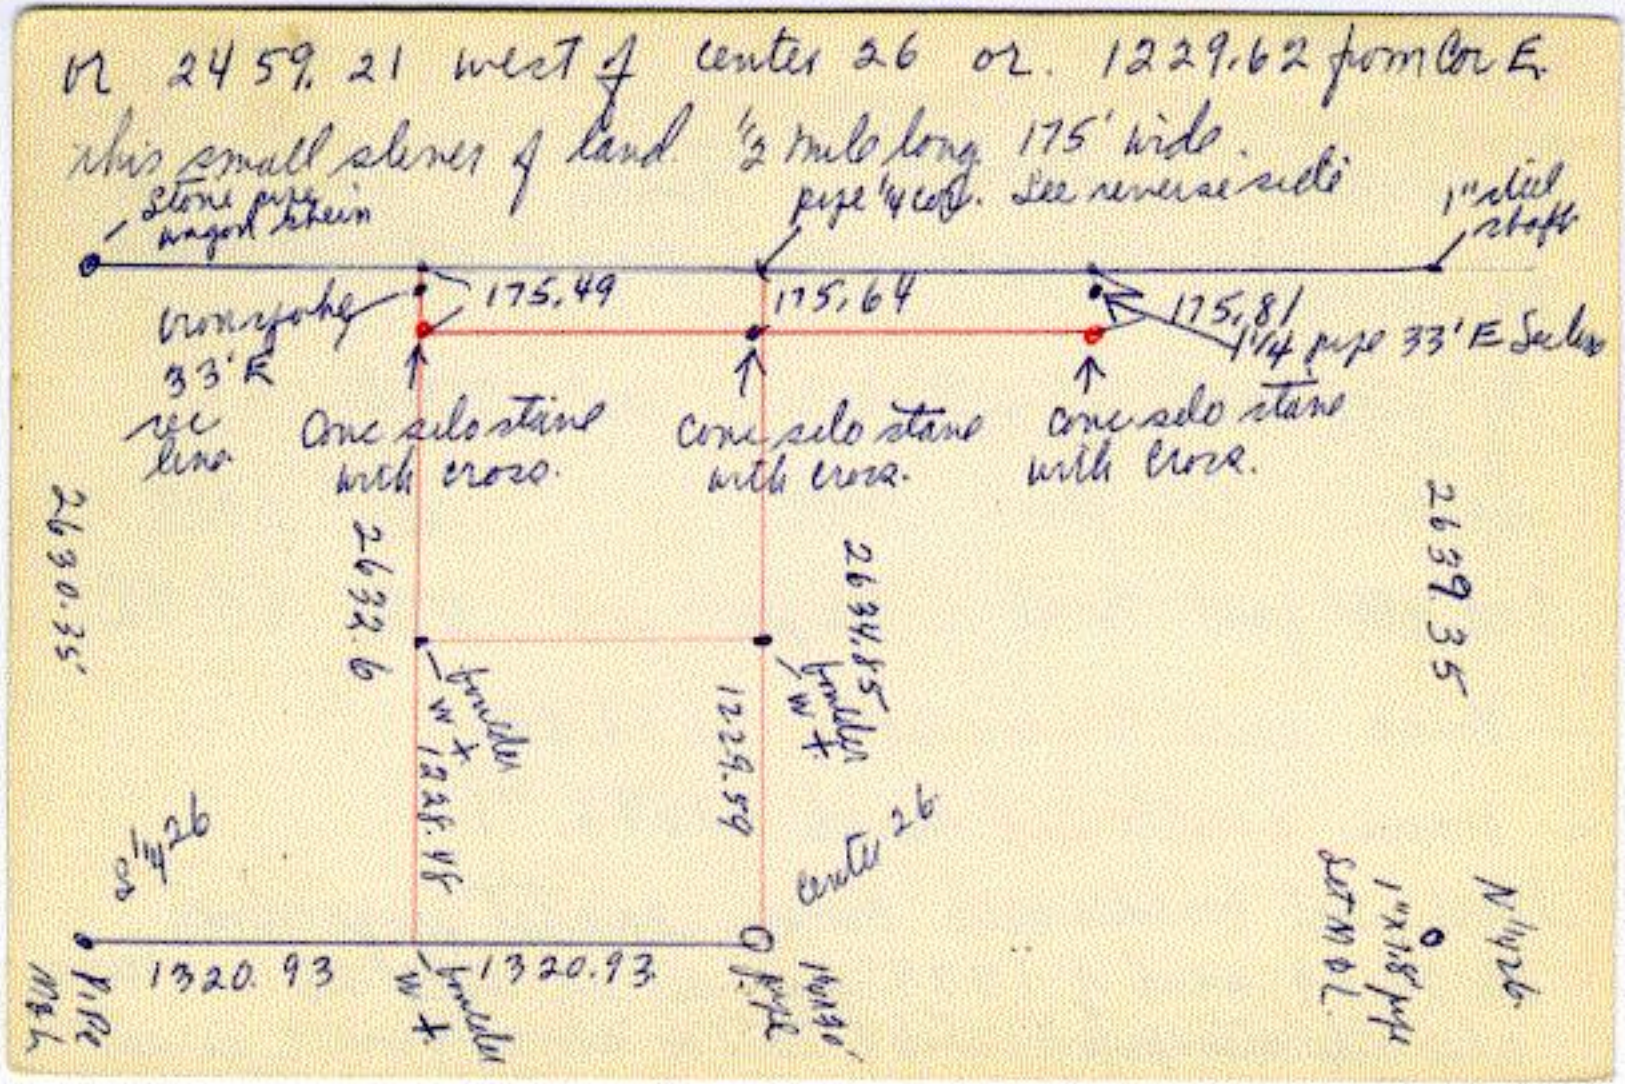
Spike cor fence post W 29.3

3rd steel post north of cor fence post NW 65.48

– Meas east to center 2634.85

– Meas south and north 2643.71

JKerr. set boulder with cross east at prop corner 12 29.59 west 1 1¼ x 4" pipe set as center 26. (cor also Silo "stone post" + 175.64 East & above 1/4 corner as set


N 24 59. 21 west of center 26 or. 1229.62 from Cor E.
this small sliver of land ½ mile long 175' wide.
Stone pile angle stakes
pipe 4 ties. See reverse side
1" steel stake
175.49
175.64
175.81
1/4 pipe 33' E Sec line
Iron pipe 33' E sec line
One silo stone with cross.
One silo stone with cross.
One silo stone with cross.
2630.35
2632.6
2634.45
2639.35
1229.62
1229.62
1320.93
1320.93
1320.93
1320.93
sec 1/4 26
center 26
N 1/4 26
1" x 18" pipe set in ground

#832606 (2)

1/4 Corner 26-27 Farmington 10S-1E

set by William Yerby 5-1854

40.00 set a gr sec post in mound of Earth & Sod deposited charcoal made trench & pits, planted Osage Orange seed E & W.

---

Co. H.D. 1953± Book 199 page 4 & page 12 (Topog.)

page 4 does not identify or stop at this 1/4 Cor.

page 12 at station 266+84 32' LT identifys fe Cor & fence west which would be near this 1/4 Cor. location -

2650± North to Sec. Cor. used in 1953± by Co H.D.

2639± South " " " " "

---

7-6-83, 1/4 Cor 26-27: Dug from ton. set in line with fences East and West and in L.P.R.11, West 3½', East 3½', North 4½', and South 4½'. Digging N-S

to cover the line of fence E & W. digging E-W to cover line from Sec. Cr. 26-27-34-35 to the center of the intersection at Sec. Cr. 22-23-26-27 assuming at this point in the survey that the intersection maintained at said corner. Found a 3/4" x 10" pipe down 2' over a 3/8" thinwall pipe 2+ long (Kerr signed removed) in a crushed rock road. (Removed all) Black dirt down 5 1/2', then 1 1/2' to clay. Conditions excellent but could find nothing further. Kerr's corner .05 South and 1.49 West of the t.n.

t.n. ~ SE 6.71 SW 6.87

pipe ~ SE 7.56 SW 6.35

---

8-4-83, 1/4 Cr 26-27: Set a CIC/p² as corner on line between the section corners and in line with fences E & W. Corner .70 East of Kerr pipe location. Corner 1/2' West of ℄ N-S road.

RP's: Punch hole in South end 18" CMP West ~~50.71~~ End bent 7-14-94

Punch hole in North end 18" CMP NW 40.37 Good

CSD in corner post East ~~50.06~~ 50.18 post leaning 7-14-94

1/4 Corner 26-27 Farmington #832606 (3)
108-13

7-30-93 Set Ref pipe w/cap East of corner on North edge of field drive. It falls 37½' East of ℄ C.R. #11 & 1' North of line of fence East.

T @ Ref Pipe

4 Rt From center main radio tower SW of Cor to 1/4 Cor 26-27

48° 47' 36"

VA 92° 48' 14"

Slope 38.12 Hor 38.02

7-14-94 SET 1" SQ PIPE W/CAP AT 1993 REFERENCED LOCATION. THE CORNER FALLS IN ℄ CR # 11 & IN LINE OF FENCE EAST.

R.P.'s PUNCH HOLE IN 18" CMP NW 40.37 CSD IN CP EAST 50.18