10-9-1965 set C/M over 5/8" x 10" rod. Range (1)
7-22-1976 Chg - accepted this C.I.M. as being corner Stone Creamery

Section Corner South 32-33 Farm, 108-13
North 4-5 Haser. 107-13
#833305

3-1898 H Fraser P620 no 563 L5 H Hendrickson
D Wilder, N Mich

found stone as corner.
-16 south set stake and long stone on line at 21.11
1393.26 then 20.09 to 1/4 stone set. (1325.94'
- Meas meas 39.80 to stake found, stone set

Co Hwy Dept - 1936 found orig recorded stone B81P43
corner long used by road and private surveys.
Meas meas 3260.4

1936 R.P.'s Sp in 12" Ash NE 49.5
Sp. in 30" maple SE 43.9
S.E. Cor. Creamery Farm - NW. 57.8

1941 R.P. by Kalb
Bolt in Top of Conc. Blk - S.E. 73.2
Disc in Ash Tree - NE 70.5

book #124
lower

10-1965 J Kerr

Note Co. Hwy Dept. 1936 B. 81 P. 77
Ties To Pt. 70.5' W.
disc in 15" Pine — S.W. - 60.7 = disc in 15" Pine South 41.1

dug in blacktop from reference, found 60 D down 18"
corner either dug or gone.
set C I M over 5/8" x 10" rod bottom rod would be 3' no stone.
SE corner Old Range Creamery Bldg (not main bldg) NW 57.8 ~~57.80~~
120 D NW side 14" grun'ack up 10" NE ~~70.2~~ 70.15
bolt on top concrete pillar 18" square up 24" SE ~~73.6~~ 73.67
Disc on NE side power pole. SE ~~71.4~~ 71.35

11-5-70 Co Surv. run & meas line meet set S 1/4 32 on
direct line inters by line from Center 5 107-13 over 1/16 N.
IAN Dickie 2 Stone.
- meas W 2624.12 to S 1/4 32 then 2628.43 to SW 32
R 2626.8 M & L.


743 North } stone
735 West }

#833305 (2)

Section Corner South 32-33 Farmington 107-13
North 4-5 Haverhill 107-13

By John Ball 10-1853
80.00 Set post for Cor to Sec's 4, 5, 33? 32
Burr oak 20 S 55E 130 lks
Burr oak 18 N 50W 544 lks.
& dug trench per instructions planted SE Osage Orange NE Apple.

9-22-76 Dug with backhoe and found CIM to be over 2 stones. One stone 2½" x 5" x 10", the other 4" x 7" extending into clay. Stones 3½' deep.

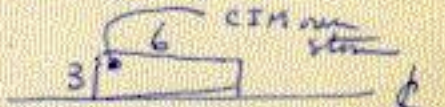

9-23-76 Set CIM over 1¼" x 20" light pipe back @ John Kerr's location. Corner 1' E of fence 5, 3' N ℄ E-W road, 3' W ℄ road N.

R.P.'s: SE corner old Kinge Creamery (not marked) NW 57.80

RP's/120d on NW side 14" green Ash NE 70.15
Bolt on top concrete pillar 18" Square up 24" SE 73.67
Disc on NE side of power pole SE 71.35

11-27-96 FOUND CIM IN GOOD CONDITION 4" DEEP IN BLACKTOP
CR #14

(833305)
(42)

6-14-99
MW, RF, AE

SO Sec. Cor 32-33 108-13 Farmington
Fd CIM 5" deep in Blacktop
CR# 14 1½' North of ℄ & 4½'
East of ℄ 40th Ave NE running
North & in line of fence South,
Set Ref pipe SSW of Corner
33½' South of ℄ CR #14 and
4' West of Fence line South.

To Ref Pipe
Rt PK in P.P. (No #) (1st pole north
of Corner on east side 40th Ave NE
to South ¼ 33

352° 35' 12"	354° 08' 06"
0° 00' 46"	1° 33' 40"
352° 34' 26"	352° 34' 26"

To S ¼ 33 (CIM)
Vt 83° 09' 58"
Slope 35.655 Hor 35.405