#840207 (1)

/

section corner North 2-3 Aronaco 108-14

12-1895 H Fraser P586 No 534 L2. C Disco, F King.
C Kurth & others.

Corner in open field & could not be found.

run & meas line from NE 2 to NW 3 where corner was stake set by Chas Fraser & undisputed.

set long limestone on direct line and gave perp. meas.

— west record. 80.15 5289.9 set at 79.58. 5252.28.


— east " 79.35 5237.1 " 78.78 5199.48.

— 16 east drove iron stake M & L. 19.69½ 1299.87 for line south.

9-1972 extensive electronic traverse from N 1-2 West to S¼ 33 10 9-14 see details in office.

— over —

Corner used in power dam flowage 6 25 000 survey · 1930?
now under lake in Main body of lake.
-16 east iron found and used. Now in hill sloping east under power line. Well reference & Meas. & notes found.
See N 1/4 2 8-24-72.
-16 west C/M set as 1/16 on south line Portier Sub. under new 4 wire steel post fence set by Lowe Rusch.
also C/M set on town or county line east of 1/16 corner about 5' from top of bank west side lake.

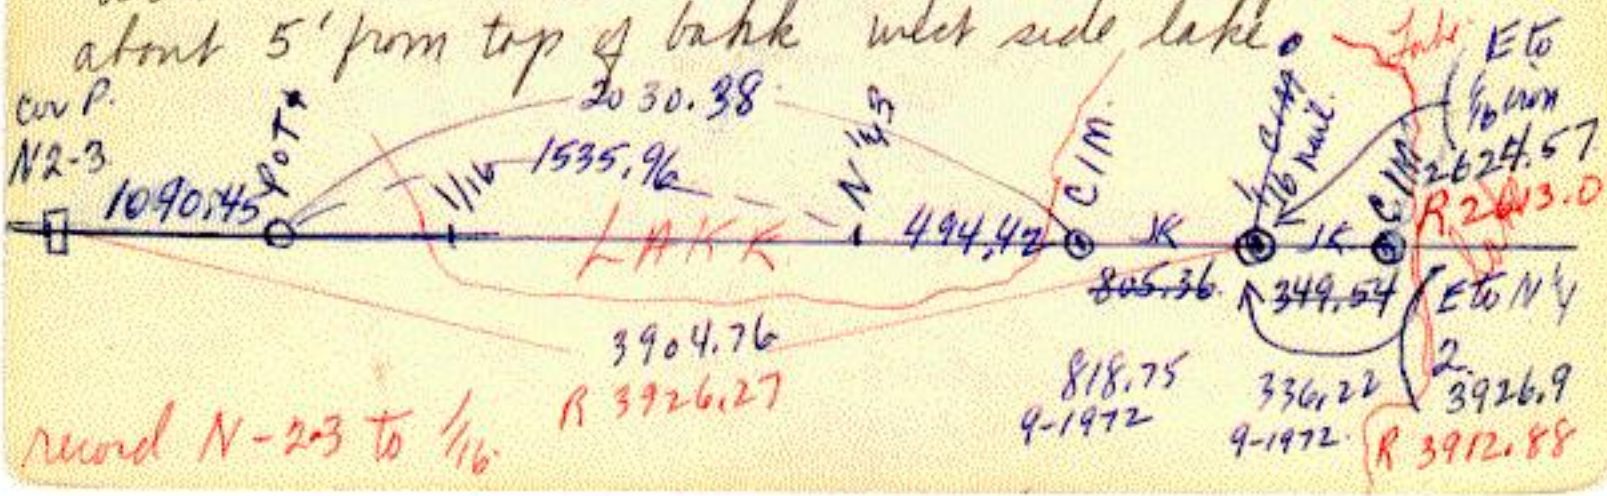

Section Corner No. 2-3 Oronoco 108-14
#840207 (2)

P.D. Survey (1916) Stone Found

measure South 2670.2
West 2626.3
East 2602.0

P.D. measured west to So 1/4 Corner 34 108 14

657'

Gov't Notes M. Kavanagh 1851
80.30 intersect Standard parallel No. 2 995 lks
East of 1/4 Section post in South Boundary
of Section 34 of Township 109
Bur Oak 10 S43 W 147
Bur Oak 14 S67 E 100

8-1990 By drawing 3-25 Roger set this corner at intersection of line from 2-3-10-11 over 1/4 2-3 and line from N 1-2 over N 1/4 2
Good meanine East and South but apparently W.M Fraser 1/10 E then 2.23W and 1.61 N of M+L (see card 3 of N 1/4 Cor 2)