#840208

6-6-1964 set C/M over 5/8" x 30" rod in place orig stone.
6-3-1965 removed & referenced to grade road over hump (1)
C/M reset after 20+ grade had settled.

1/4 corner North 1/4 2 Oronoco 108-14.
12-1895 Jr Fraser P586 No 534 & 2 C Saco, C Keith
set long limestone M&L. 39.39 2599.74 A. King & others.
1299.87
-16 west drone iron stake M&L. 19.69½ To
long limestone set on line NE 2 to NW 3. ac NW cor 2.
- west to C/M set ac. South Sec corner 34-35 Wab Co.
109-14. 657.0
ties to above. Nail in Base power pole NW 32.73.
120 D as temp RP set there $100.00 gen field.

6-1964. J Kerr found. 12 x 12 x 24 limestone set vertical with digging marks showing it had been set. on accurate range line in lane road south & fence north. set C/M. over 5/8" x 30" rod.

- when road over very precipitus ridge east graded out to make straight road. removed C/M. & referenced.
- replaced later after road 20'± fill had settled.


Old ties. Hub 12" Beak NE 41.4 corner lay 3' north of
Elec tele pole NW 42.1 line of power poles west
" power pole W 234.4.

RR on removal azimuth Tie 348° 2 irons or 120 @ 70' & 140'
. level chainage.

P.D. Survey found stone meas. East 2629.5 ?
West 2602.0
South 2649.0

Card # 2. North 1/4 2. Arroyo 108-14 #840208 (1)

8-24-92 ran line and traverse, electronic, from N 1-2 west to N 2-3., set PoT on line on hillock just east of N 1/4 2., found this line fell south of 1/2 iron set by 21 of race 12-1895, this iron 1" solid rod up 8" leaning NE ly or downhill slightly. and like 10.0' from 1st power pole on steep slope or 3rd Power pole west of Dream Acre road north. about 2' E of North 10' of PP # 35422. ac 1/2 fell north of first line set line on N 1/4 2 direct to 1/2 iron and projected this line to PoT on crest of hill above trees blocked line so Taped point on high hill S of Posters point where PoT and all points on S line Posters point Could be seen. Pot. Line 10' 2'S of E to anchor cable and 16' S Ely to Center PP # 35423 on hilltop

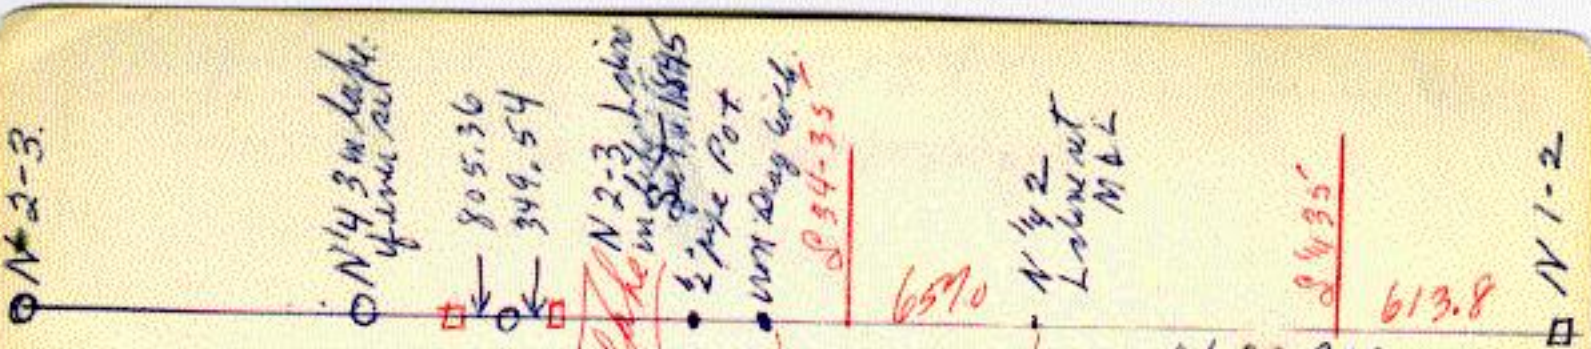

R1299.87

final 1300.12

Mds 5252.28

2626.14
1313.07
3939.21
805.36
3133.85

Mds 5199.48

final 2600.4

Card # 3. N 1/4 2 Aroco and E-W lines of Sections 2 and 3. from N 1-2 west to S 1/4 33 109-14 #840208 9-18-72. projected line again west from C/M at N 1-2 over N 1/4 2. (now only hardly 2" deep) direct to 1/16 west and P.O.T on hilltop - pulled well Fraser iron a 28" shaft about 5/8" dia. tried to drive it on proper place but found ledge. so set short drag toolbox 3"

3.87 W N W ly to PK on S side oak bore pos.
9.33 S S W ly to PK on E side P.P. 35422.
9.7 N ly to bo nail on E side of 10" tall oak.
set 1/16 on projected line at 1300.12.

Moved 1/16. 2.23 E - 1.6134 top W Fraser bearing shaft ok. P.O.T

set 1/2" x 18" black pipe as P.O.T on line projected from N 1-2 over N 1/4 2. at 1558.68 set Hub by it

16.44 SE to cone nail & tin side PP # 3542 3 (up 12"

12.6 5' N & E to angle punch mark on top

[illegible] ball of low anchor of PP 3542 3.

about 8.7 North of West pole E.

8-90 RD Interpretation:

After setting N2-3 at the intersection of line from N1-2 over N1/4 2, and line from 2-3-10-11 over 1/4 2-3, Roger set the 1/16 W of N1/4 2, a drag tooth N & L. It came 2.23 East and 1.61 South of W. Frazer's iron (removed). He then set 1/2" x 18" pipe 1558.68 W of N1/4 2 on section line

2 see Dwg 3-24 For possible difference