#840209

X

1/4 corner Center 2 Oronoco 108-14

12-1895 H Frasee P586 No 534 S2 C Sisco, F King.
C Kurth & others.

drone iron stake with pile of stones around it at true intersection lines.

- Meas east 39.45 To long limestone set in place of stake.
- 16 west set iron stake N&L 19.73
- 16 south set stake N&L 20.07 Now in lake.
- 16 center SW 1/4 2 drone stake intersection lines.

1/64 corners S 10.03 & W 9.87 1/2 from above 1/16 corner.

- over -


5-1925 J Kerr B-6 P12. run E-W 1/4 line with
big Triangulation accross lake.
Set or found. iron at center 2. on L E side 2" pipe cor P
5203.3 accross section at 1/4 line.
- fences E-W-N not south.

7-1946 J Kerr. run line from center south.
set 3/4" pipe on crest of hill looking south at 925' south
of center 2. -10" burr oak LW 14.75 = 10" burr oak NW 23.2
note run same line in 1950s - found 3/4" pipe easily. con't
line to waters edge only.

South Sec Cor 34-35, T109N, R14W File W.M. N'/4 2

12-1895 W. Fraser (P586 No. 534) needed to set the N'/4 Cor 2 and N 2-3 but apparently could find no evidence so measured and ran line from N 1-2 (stone set by Hunter (page 359) in place of stake) to N 3-4 (stake by Thomas Fraser in place of Govt stake) and set N 2-3 on line and prorated Govt measure and then N'/4 Cor 2 midway and on line.

Appx 1916: Power Dam Survey: Shows "no stone" at S34-35 but measure of 657' West from N'/4 Cor 2 (stone) to S 34-35 and straight line from N'/4 Cor 2 to N 2-3 (stone)

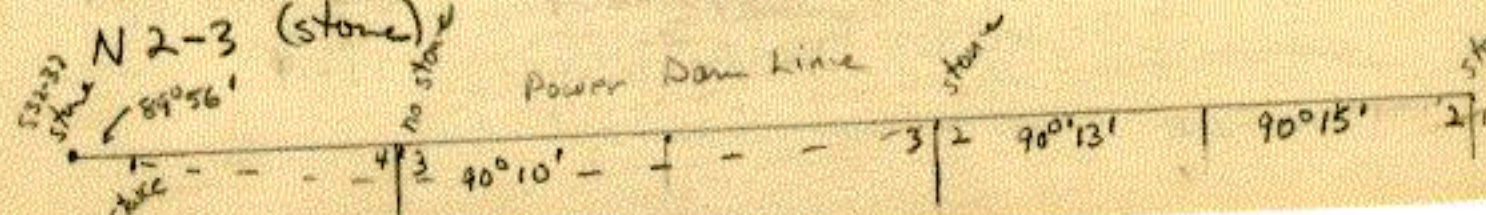

1910 Letter From Rafter to Thomas Fraser states corner in Field and Found nothing but pile stones at N1/4 2 and N 2-3

6-1964 John Kerr Fd stone at N1/4 2 } rammed 1965 For grading and reset Fronties

7-1964 " " " " " N1-2


N1/4 2 Card: Measure 657.0 West to CIM set on S. Sec Cor 34-35, T109, R14 (believe this John Kerr Data)

N 2-3 Card: AFter 1972 survey CIM @ S34-35 "may now be a little North of line"

1925 Kerr Bk 25, Page 9 Kerr Finds NEL, N1/4 2, 1/16 W of N1/4 2 and measures this 3/4 mile but does not mention S34-35

8-10-64 Ken Wolanka Book (Page 22) "From N1/4 Cor Sec 2 Raul W. Az 270°13' 657' For Section Corner 34 & 35 — 109-14". Surveying N in Sec. 34


P61: Used corner to survey road into Dream Acres

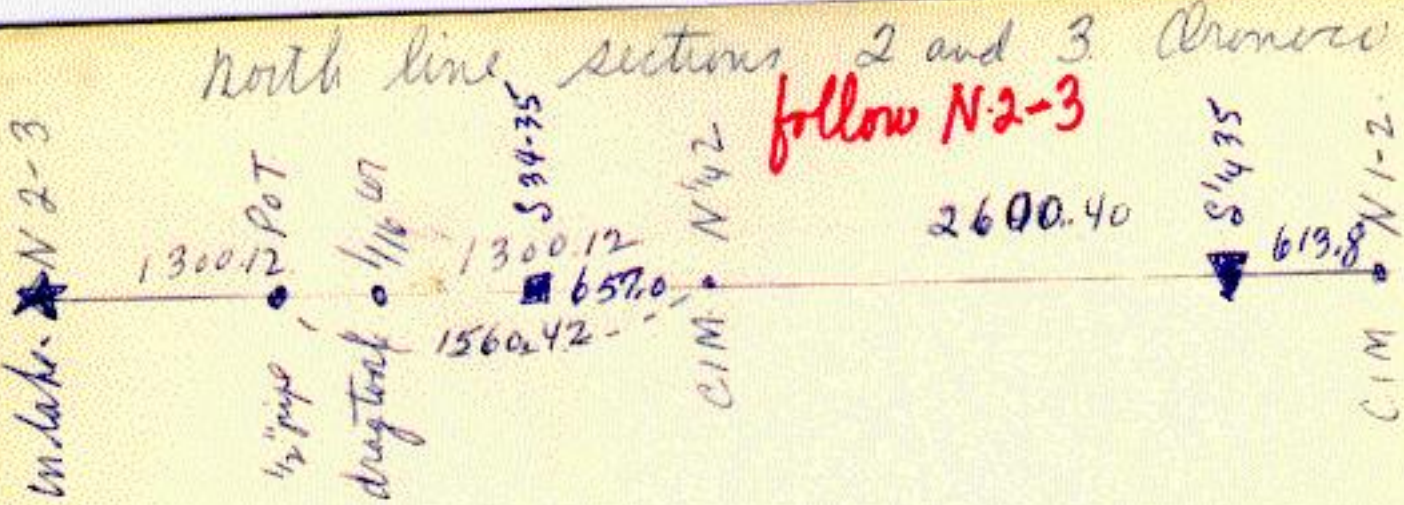

■ S 34-35 wab co 657.0 west of N ¼ 2. (may now be little N. of line now.
CIM

▼ S ¼ 35 wab co 613.8 west of N 1-2

★ N-2-3 in lake an assumed computed point on direct line over N ¼ 2 from N 1-2 reset by Frazers 1/16 iron on line & true midway could only set drag tool in solid rock bar pushing Kerr Co line (N line Posters would fall 1.2 N of this comp corner

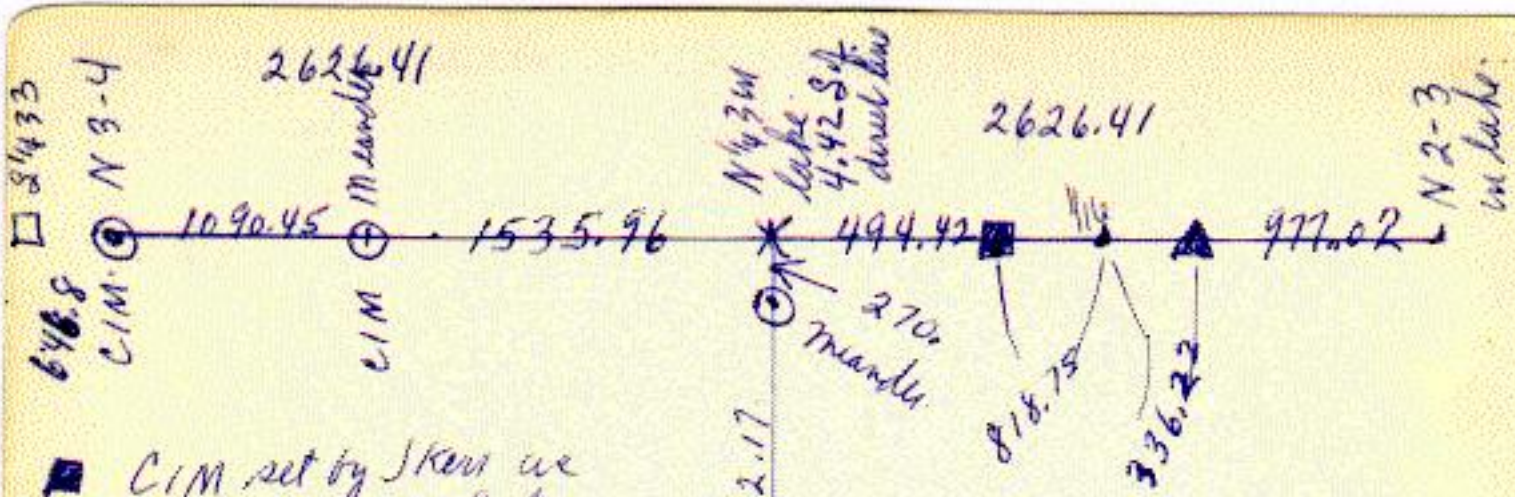

■ CIM set by JKerr at SW cor Pozhers Sub

▲ CIM set by JKerr at SE cor Pozhers Point Sub

Iron rod

line between these used as N line E½ Sec 3. to avoid changing entire line creating 4.42 kink at N¼ 3 and this line pushed east to E Bdy N 2-3 fell 1.2 N & comp corrected.

CIM at ¼ set by JKerr will be moved to above mean of 13.42 east (will not be CIM unless on block corner ?

S ¼ Cor 34, [redacted] T 109 N, R 14 W

File with N2-3