#840307 ①

9-22-92 set C/N1 iron 5/8" x 2' rod


section corner north 3-4 Oronoco 108-14 W.co.

6-1891 Chas Fraser unrec. P95 black book with flap.
found marked stake claimed by Goldberg. to have been
placed where orig corner stood 25 yds before.
5-9-1882 Hunter. unrec. P138 B5 set stake M&L 39.89 2632.74

5-1892 Chas Fraser P481 No 458 L3 Town board.
found corner - refered to former survey in record book
there are none of L4 only above.
shows 1/16 corner south for line east.

12-1895 H Fraser P586 No 534 L2 C Sec, 4 Kang.
found stake used by Chas Fraser in 1892. C Kurth others
then Co Surveyor. agreed by Mr Holbeck as true corner. - over -

used corner to set north corner 2-3. which was set on straight line NW cor 3 to NE cor 2.

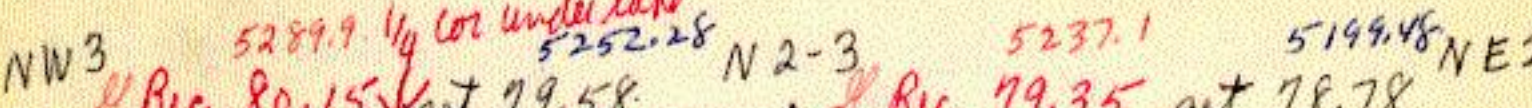

1972 5252.02 CIM set as 1/16 cor ~~5252.10~~ stone set, now under lake. 1895

1972 5200.64

postless point.
also CIM exact on Lake shore edge.

9-1-72 reset corner after weeks of electronic traverse Calculation. set CIM with 3/4" x 3' pipe below and 5' highway channel iron post on west side - corner comes in sharp clay slope. on west side of lake lagoon waters.

14.0 SE To 60 D 12 Nly side hwy 3'+ oak up 4'.
43.0 SW To 60 D on SE side 3' red oak up 3'+
20' E To old corner post & fence west and south.

VOID

#840302 (2)

Board # 2. North 3-4 Oronoco (4) 10 8-14.
-9-14 reset ~~Book 6 & Page 2~~ See S 433 10 9-14 Wabasha. Mazzoja Lucy.
pulled angle iron set 9-1 and set 3/4"x4' pipe 3.4'N, .55'W.
RP now 5.95 W to small cross in N Culvert headwall leading
to field no headwall on S end of culvert, pipe just
north of quartered wood corner post.

-9-22-72 See Oronoco Bk 1, P 2 after final elict. computations reset C/N at
N-3-4 with 5/8"x2' iron below and 5' highway channel
iron post on north side corner with east edge could
be used as sight from south. (final)
44.6 SSW to 6" D on E side large oak.
15.7 SSE to 6" D on NE side huge red oak.
corner 70'± E to west edge lake Zumbro lagoon.

over.

Meas west to S 1/4 33 109-14 Mazuma Trap 646.8
Meas south to 1/4 3-4. 108-14. 2689.38
Meas " " 1/16 1364.21
" " from 1/16 distance diff to 1/4 3-4 1322.42
" east to C/M meander corner P.O.T. 1090.45
" " " point in lake 270' N of meander N 1/4 3 2626.41
or 1535.96 from meander to N 1/4 3 in lake.
Note - N 1/4 3 computed as 4.42 S of direct line.
Meas meander P.O.T east to C/M. SW cor Perkins Point 2030.38
RP to 1090.45 meander C/M
214.75 ESE to 60D in S. root base large 20" tr oak.
109.93 NW to Conc nail in Rochester power trans pole.
95.02 S to " " " " " "
40.53 N to 60D E side double blazed 12" oak

(3)

Oromaro section corner North 3-4
Govt Meters M. Knuck 1854
80.60 Intersect Parallel No 2 980 links East = 646.80 #840307
1/4 section post in South Boundary of section
33 Township 109

Jack Oak 7 5 61 W ~~5~~ 195 = 128.7

Bur Oak 10 S 51 E 330

4-11-83, N. 3-4: Found CIM and R.P's OK. Corner 20' West of fence corner to fence West and South.
Our traverse here comps. meas. West to the S 1/4 Cor 33
~~647.97~~ Mpaume here was Govt 646.80 in 1972!
~~See Rec. of~~