S 1/4 Cor 32, T 109 N, R 14 W (File with N 4-5, Oronoco)

4-19-83, S 1/4 32: Chained appx 640.20 (600+ tie) from N 4-5 (Kerr shaft replaced with CIC/P²). Found 1" shaft (up 6") standing 4' North of E-W fence at the appx measure.

6-6&7-1983, S 1/4 Cor 32: Dug from 1" iron Found here 4-19-83 for 3' North, 3' East, 3' West and 5 1/2 South (to 1 1/2' South of E-W fence) by 2' deep to clay. Iron not set when anything. Could not even find an old post mark though several old old posts are lying on the ground beside present fence. Set iron back. Digging to cover Govt measure from N 4-5 and to look under E-W fence


line. Measure from 1" iron to N4-5 = 640.22

RP: Pop Cap on W. side fence post South 3.89

1/4 Cor. 32-33, T 109 N, R 14 W, (file with
N 1/4. Cor. 4, Oronoco

8-22-83, 1/4 Cr 32-33: Found 3/4" pipe on North side of dead tree. Woven wire fence from West terminates at tree. Edge of woods running North, but found no other fence at this time.

Completed traverse South to job in Sec. 4 Oronoco
DRWCo 5-19.

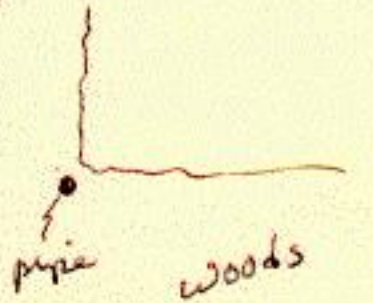

01-2000

"840409" Cen 4 Oronoco 108-14

Vince Fangman computed center at intersecting quarter lines

11-1999

"840409" Cen 04 Oronoco 108-14
Vince Fangman computed center at
intersecting quarter lines

1-00

"840409" Cen 04 Orenoco 108-14

Vince Fargman computed center at

intersecting quarter lines