/ 6-16-69 set C/M over 1/2" rod at interior range & 1/4 lines
#840508 (1)

1/4 Corner North 1/4 5 Oronoco 108-14 & W ab 6-1894. 2t Frasch P550 no 508 L 5 & 16 A Purce Co. could find nothing at this corner whatsoever. 2t Rubel. J & T Hoffman. drone iron stake 3' long M & L. 40.08 5/8.

-16 east set stone M & L 20.04 5/16.

-16 west " " " "

-16 south drone stake on line 20.38 1/2 then prop. cor. south above 1/16. 10.96 1/2 then 89? to center 5

-16 Center NE 1/4 5 set stone 6x6x18 at interior lines

-16 center NW 1/4 5 set stakes on N-S 1/16 line south at 20.42 ± then 10.93 ± then 8.96 ± to 1/16 cor.

6-1969 JKerr meas from fence east at N-4-5
set 120 D at 26.46.0 - later N 4-5 found 2.9' West of fence
and stone 6.3' west of 120 D at 1/16 making 1323.4 ✓ later
found N 4-5 as hole in clay where stone was set at 1323.2
- hole in clay had hole also .5 south which was square
at bottom indicating stake witness. this would make
iron shaft at NE 5- stone 1/16 and hole within a couple lenths of line.
hole a little north perhaps. - set 3' rod to hold corner (raining)
- recorded 1/16 corner west would come in center deep culvert (assumed lost)

Mountain Dew in knot hole in tele pole	SSW.	25.0
Cap in power pole 37615	NW.	67.6.

corner at least 1 foot south of edge road surface.

6-10 - found twp corner corrected line then run N-S 1/4 line
aerial set C I W over 1/2" rod at inters lines. Changed alone RPS
see card # 2


#840508 (2)

Card #2 N 1/4 S Aroroco 108-14.

6-10-1969. corrected range line and run line from S 1/4 S over center 5. which enters range line at 1.47' west of 120 set on random or 2644.77 from NE cor S and 2.06 E of iron rod.
and 1321.17 east to 1/16 stone found then 1323.6 to NE S 1/16 stone 1.27' south of range line set up NES to this cor. New RPS to N 1/4 S - set CIM over 1/2" x 2' rod Mountain Dew cap on east side tele pole SSW 27.88 Coke cap in power pole 37615 NW 67.75 Corner lies 1 foot from south edge traveled road " " about 33.5' east apprx center farm drive south punched cross in East end farm drive culv SW 29.56.

Coons 4-83

4-11-83, N¼ 5: Found CIM in good condition and as described on card. Telephone pole SSW was gone.

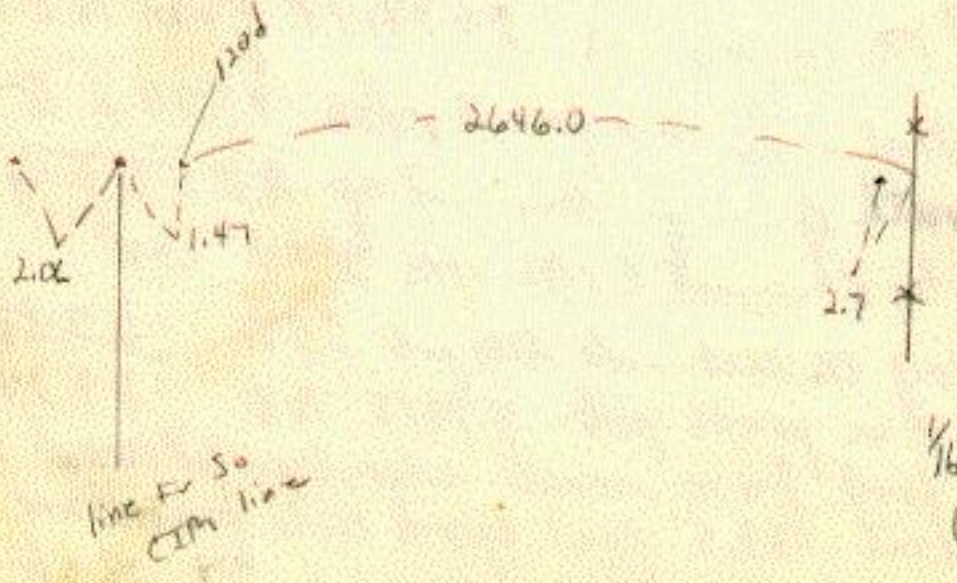

2646.0
−2.7
2643.3
+1.47
2644.77 to CIM
2.06
2646 83 to rad mark

1/16th Stone 1323.4
West of NE 5-

14 x 10 x 3 Stone

B. Oak S 57°30' W. 14 Lks.
" W 7½ Lks.

X in G.R NW 40.0
X " " SW. 64.57

1/16 Cor. on K.
1327.05 to Sec. Cor.

Sec. 6. S.A.R. No. 18
NE. Cor. W½ NE.¼ Cor. of Steel Cor. Post W 27.2
found rotted stake with flat limestone on top Disc in Tel. P. NW. 61.8 " F.P. N. 56.7

Center Sec 6 Ties to iron rod
Stone & Stake put iron rod in place of stake
Ties { X in east side Cor F.P. No. 28.6
Disc in F.P. N.W. 67.2
" " F.P. S.W. 47.6

Cen. 6 — South — by T. Ferguson & Pat
13 11.46
13 11.44