1 6-4-69 set C/M over orig stone & rod - put 4 fire & stones. #840609 glass

1/4 corner. Center 6 Oronoco 108-14. (1)

6-1894 2H Fraser P550 no 508 S6 A Pierce, W Ruber. J. Hoffman & others

drone white cedar stake at intersa lines.

-16 east set boulder stone with hole cut in top

. M&L. 20.03 3/4 1322.5'

marking any other direction.

Bearing E-W line S 89° 40' W

" N-S line due N & S.

6-1902 Ch Armstrong P56B. S6 2 Meyers, W. Mahan found cedar stake lying on road bank having been plowed out by plow or scraper - on mean 2 rods south of cor post

Amend by M. Fabian

of fence north and digging in bottom of ditch found depression of stake - set boulder 8 x 8 x 12 with orig white cedar stake beside corner. Observed by Mr. Luban
- 16 west set boulder on line and pcrp dist. at 20.00 then 18.22 to W 1/4 6. found 6-3-1969 - Questionable 1974
- also set 1/64 corner (a boulder) M & L 9.11 below. W 1/4 6 and 1/16 east. did not find.
- 16 center NW 1/4 6 set iron stake 1 1/2 x 22"
meas north 20.69. south 19.94.
also boulder M & L 9.09 west of center NW 1/4 6. with iron below.
- 16 north set limg stake at 19.99 chen. 20.54 to N 1/4 6.
- 16 center SW 1/4 6. found old stake set limestone. 6 x 10 x 16 with large boulders on N. & S. sides
- 1/64 betw Center SW 1/4 6 & 1/16 west set boulder 4 x 12 x 16 M & L 9.12

RP in old Co plat book - found 2-70 record-dist
Co had found stone & stake and set rod in place of stake.
RP cross on E side cor FPN 28.6 other RPs gone.

Card No 2. Center 6 Aronoco # 840609 (2)

6-4-69 dug with tractor found described stone with
3/4" reinf rod on S side. set full bottle iron beside iron with
several boulders near by. with C/M above.
this came about .8' south of line of 1/16 stone west and
corner post at 1/64 corner west of 1/16 corner.
very near recorded distance of 13 20 from center west.
- Meas exact very near recorded meas of 2645. maybe
about 4 or 5 tenth less.
- 16 west found stone didn't look for iron pin below.
Came just north of fence - put upright limestones on E & W sides.

Casing dia. W side cor post (1974) North 45.7
– pegs & cap on power pole 37555 W S W 120.7.
Center 3" steel pipe North 33.75
corner lies 3' north south edge road, 7' south center road,
1' east of main fence north + 414' East of diagonal road west
– 16 east in black top - drove nail in center at 1322.5'
from point at 1/4 5-6 which proved 1'± west of corner placed.
this nail is about 5.5' north of direct line E 1/4 & center 6.
7-23-69 run line center 6 east to 1/4 5-6. line came within .02'
of 5.5' - set 3/4" rod in black top on line and 1' east of &
– 16 north above 1/16 set rod in & black top at perp meas 2674.35'
1360 north 1314.35 south came onto 20' south present fence east.
– 16 north above or betw N'46 & N5-6. 120 D on line & midway
1318.4 - came 7' north fence west – 18.2 S W to L corner post.
45.6 to brass cap in tele pole N E.

~~Card~~ No 3 Center 6 Orono 108-14
#840609

CHD B183 P10± 1952 re-tie 1945± survey
RP to 1/16 corner between Center 6 and 1/4 5-6 Orono 108-14

Cross in west end of south Hdwl. culv east 18.5
" " " " " north " " NE 27.8

Boxelder - So. 16.9
Stake N.W. 96.9
Stake N.E. - 96.0

Mon north 2671.2 to 1/16 - JKerr 1969 2674.35'

-16 corner north of above 1/16 cor. set 1969


May 20, 1975 Co Surveyor - dug with Tractor farther North. - from 4'-8' N. of Kerr's CI & 5' E & W. of C.I but did not find anything. Evidently Kerr has J. Armstrong's Center Sec. 6, however I do not believe it is same Corner placed by W. B. Fraser.

Section 6 - 108 - 14

Corners Searched for in Dec. 1974 by County Surveyor

See over this sheet for info.

#840609

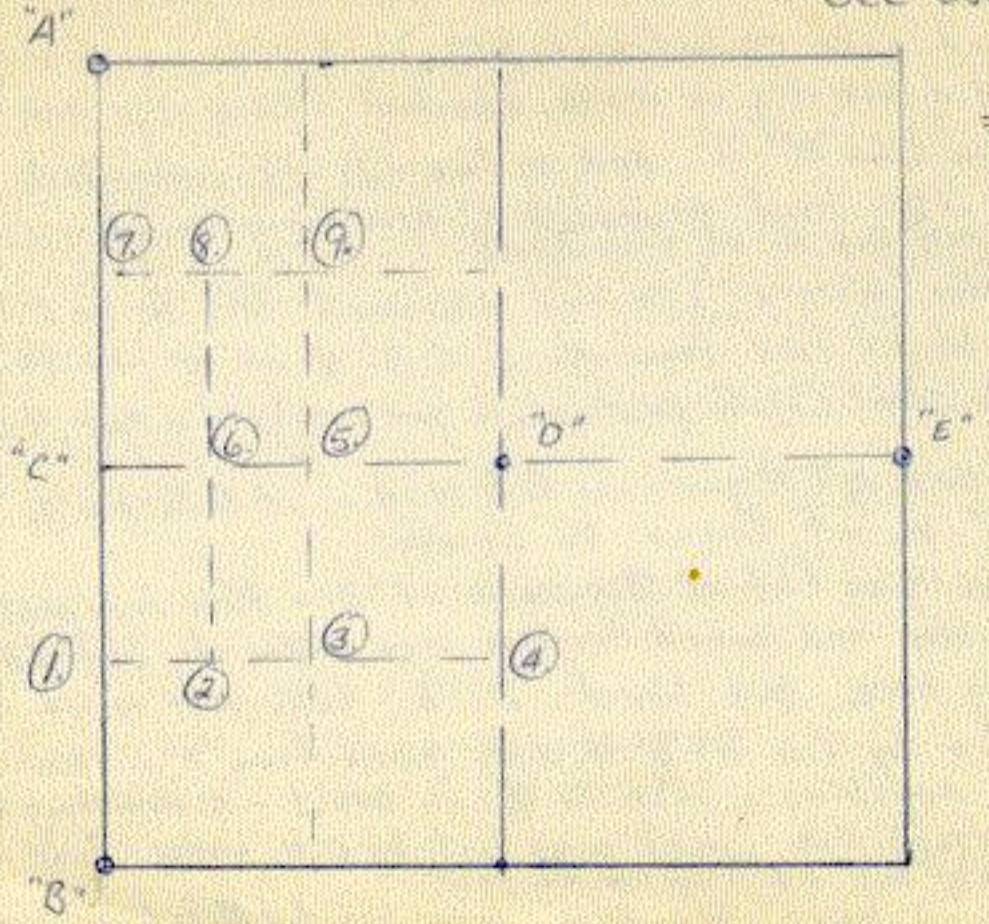

"A" - Twp Corner - fd Kerr's CIM. 13 inches deep - Set 10" CI over it ± Rd
"B" Found CIM but Boulder Witness stone gone - C.S disc in Conc. f.p - S.W. 8'
"C" Set 2 nails on Line "A"-"B" - see notes for distances -
"D" - fd - ½" rod over Monu. (checked Ties) - ± 7' So. of ℄ E-W Rd ℄ line fe, N.
"E" - ~~none~~ did not dig up monu. checked Ties ℄ dip set Lath for sight.
(1.) dug hole on Line "A"-"B" and on line (2)-(3) extended - Set ¾"x12" rod on Line "A"-"B" and projected C. Armstrong Mont over "A"-"B" This point only 0.6' So. of Line (2)-(3)
(2.) found boulder (4"x10"x?) Pointed assumed this To be C.A. Stone, it is ± 1' W. of line fence N. ℄ ± 2' N. of E-W fence
(3.) found 4" dia. steel Cor. fe post (single post only) Set in Conc. & Leaning South.
(4.) iron rod set by T. Ferguson in fall 1974 - it falls ± 8' So. of fence East and ± 10' W. of fence To South.
(5.) fd - boulder lying flat at 1320.56 W. of "D" - Kerr accepted this as ¼ Cor. Removed boulder and looked for C.A. iron under it, but did not find it.
(6.) did not dig here, but line of "D"-"E" falls just N. of Cor. post
(7.) dug hole here by Line "A"-"B" & dist. mgmd from "A" - 1376'-1378' but did Not find anything - dist. To (8.) is 606' ± - C. Armstong mont was 599.94'
(8.) fd - 1½" dia (Top) iron which was set by C.H. under Stone - Stone is gone. it falls ± 2½' N.E. of 8" Sq. Cor. fe post.
(9.) dipped around here for C.A. iron but did Not find it - falls in Sh. of Rd

SW Cor. 31, T109N, R14W (File with N¼ Cor 6)
SE Cor. 36, T109N, R15W 108-14

6-9-83, SW Cor 31: Attempted to dig for corner in pasture centered 13.9 West of the 4.n. (set on So. side post in E-W fence in line with a fence running North apparently on E. side old road that used to run North here) Dug North 3½', West 2½', East 2½', and 2½' South by 4' deep to clay. We were digging to cor on 2640 from fence North at S1/4 36, 109-15 and also ¼ distance from said S1/4 36 to cor Found at S1/4 32, 109-14 (N 2639.4). Old road formerly running North and West here obliterated by Hoehne. Entire hole filled with boulders of all sizes. Very little chance for a corner. Could not dig further North under fence! Line from

NW 6 to N 1/4 6 (J Kerr and W. Fraser line) appx
3.7 North of T.M.