L corner in lake. C/M set as meander north 160' on line
#840805
section corner. 7-8-17-18 Oronoco 108-14 (1)
5-1892 Thos Fraser p485 no462 L8 M Hautzinger
Corner gone - fence line north claimed by Mr A D Alber
as in line with corner - Meas from L E cor public square
at platted distance and it came to fence north.
- Run line from L E cor 8 over L 1/4 8 and set stone
7x7x13 at inter this line and fence north or platted meas.
- 16 North set stone M & L. 19.81 3/4 to stone 8x10x15.
(1308.

Corner found long pipe set as corner.. then corner
destroyed in working on lake edge with power machinery
- ones.

Corner now out in lake considerable.
should be meander corner rod. 81.0 east also.
Cast iron meander corner set 8-11-1965
at ½" rod long set as line on lake shore.
This C I M meander corner 159.09 160.' north of true corner on line.

20 D in hub	12" B oak	S W	7.6
" " "	16 "	N W.	6.32'
Angle iron steel fence post		N	.8'

-16 north steel rod in road. RP= Note 1308.87 M & L.
-16 above lies 1149.12 north of Meander.
- a meander rod set 81.0 east of corner when it was in place in lake, this rod on section line. also run at 500.' and 634.3 which is NW corner Hollister sub 254.06 west to sec. cor. 276.92 east to ¾" iron on W line of Sec 16
4-1970 east line Ash street projected to intersection line set as Meander east.

#840805 (2)

Card # 2. 7-8-17-18 Aronow 10 8-14

1/16 corner 1308.87 north of true section cor B86 P25.

10-1962 RPS ~~45.7 to cross in top N Calv headwall~~

4-1970 BLM ~~64.13 " " " " S " "~~

- set meander corner ~~140~~ 160 = 159.09 north of true section corner.

RP meander cor 10" brook W 7.8'

14" " " NW 6.2' center trees.

- set 2 Ash stkt on 1/16 line cart 229.4 east of 1/16 cor.

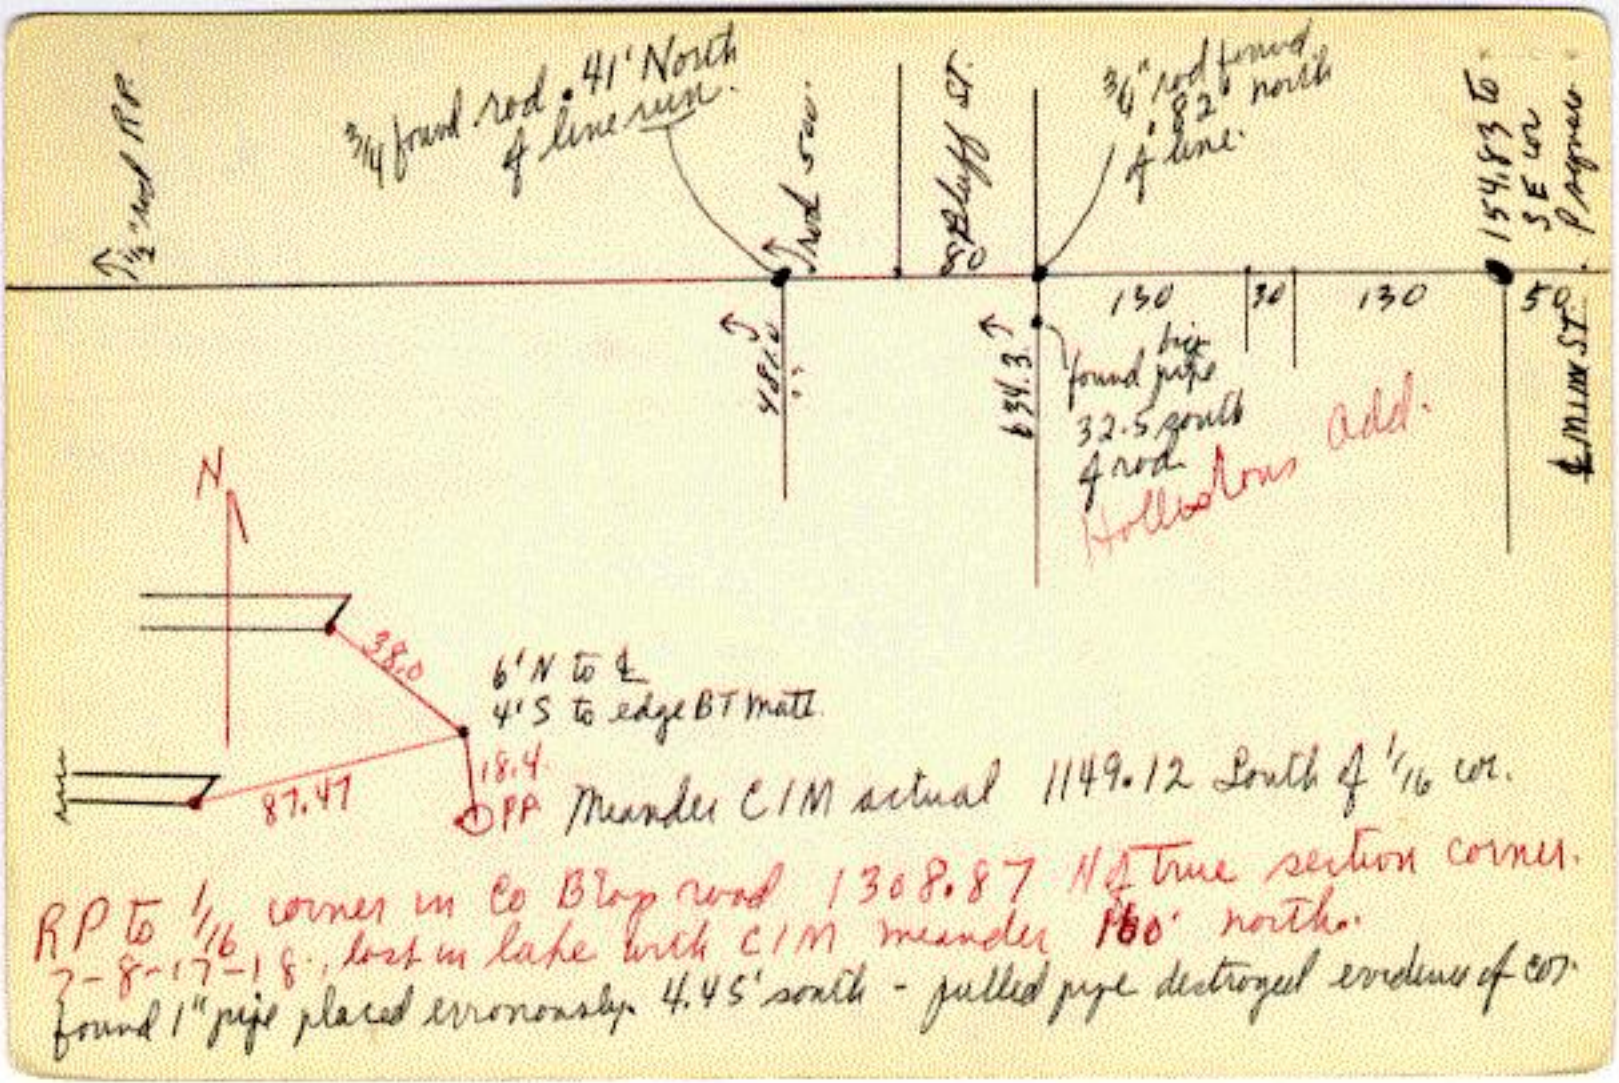
RP. 1/2" rod as cor. Sp D T.P. SW 48.2.

NSide Sp D P.P WNW ~~760~~ 4' N & W 77.1

& rodd N 40.5, SE Corner new addn on house SW 86.75

See B 84 P 6 and 9.

B 86 P 25 Survey Blk 5 lots 4 & 5


3/4 found rod
41' North
of line run.
Road
82' north
of line.
154.63 to
SE cor
Progress
130
30
130
50
Found pipe
32.5 south
of rod
Hollidays add.
N
38.0
6' N to ℄
4' S to edge BT matl.
18.4
87.47
PP
Meander C/M actual 1149.12 South of 1/16 cor.
RP to 1/16 corner in Co Bldg road 1308.87 N of true section corner.
7-8-17-18, lost in lake both C/M meander 160' north.
found 1" pipe placed erroneously 4.45' south - pulled pipe destroyed evidence of cor.

Card # 3 7-8-17-18 Aronoco 108-14 (3)
#840805

summary of meander corner location.
C/M lays 160' north of true corner
12" oak SW 7.6 — 16" oak NW 6.32'
County property corner SW corner lot 5 Block 41 South ~~4.75~~ 4.75 O.K.
- also set 1/2" rod east as new meander corner which is east line Oak street projected to intersect section line
- old meander corner set 81.0' east in lake but found likely lake in lake bed which proved line ok
- found 3/4" rod in concrete as NE corner of property in Mill Res as 481.0 from sec. cor and 227.0 to E line Oak street
Corner as set came 226.92 from rod with rod .41' north of true line across.
- found 3/4" rod with large pipe 32.5' south under fence which is NW cor Hollisters Add. this rod at 634.3 and .82' north of line

1936 - C.H.D. - Book # 81 page 60 Iron stake set

For Corner on west side of Corner fence post
at Cor. 7-8-17-18 (meas. To E 1/4 7 North 2622.3) poss. bdy set 1/16 N.

1/16th North 10-29-77 Dug with backhoe at Kerr's rod. Found an iron by a shattered limestone .2E and .9'N. Dug deeper and found a stone 4"x8"x15" with stakes on the West side 7' deep. Set a 1¼"x20" pipe in stake hole and iron around the stone. This corner .08'E and 1.58N of Kerr's corner (removed)

LRP: John { 17.9E / 17.9S Iron & shattered stone { 17.7E / 18.8S Set nothing @ surface Stone and Stake { 17.82E / 19.48S

Card #4 7-8-17-18 Oronoco 108-14

In oct. & Nov. 1977 as the result of an elec. Traverse survey in Sections 7, 8, 17, 18 etc #840805 I decided that the location of this Section Corner should go at the location produced from the North. J. Kerr's 1/16 Cor. North has been inplace for many years at this 1/16th Corner and used for all recent Surveys in this vicinity. The Meander Corner location which Kerr called as 170' North, really was 160' North, but upon our more accurate meas I dec.ded To use the M.C for line from the E. 1/4 Sec. 7 To this M.C which makes the 1/16th North about 0.15 East of that line. (over)

Then for N-S Location I ~~doubled~~ used the distance from the 1/16 Cor. N. (Kerr's) To the E 1/4 Cor. 7 and used same meas. South of 1/16 Cor. which now makes the M.C. at 159.09' North of Sec. Cor 7-8-17-18 as we are now going To use it. This location is further substantiated by the distance So of the S.E. Cor. of Public Sq. as shown by J. Kerr = 154.83 and now about 154.7 also the line of S 1/4 Cor 8 from SE 8 as used and Set by T. Fraser 1892 is now about 2' N. of our new location. See Card #3 for 1/16 Cor North info. - note that a stone was found 1.58' North of 1/16 Cor which we are going To use

See Card #5

Card #5 7-8-17-18 - 108-14
#840805

On the back of Card#2 is a sketch of the line East of this Sec. Cor. of some work done in April, 1970. This indicated that a line slightly north of the one used in that survey could be located as per iron rods found 0.41 N. & 0.82' N. of line as used.

Kerr's 1940 meas. from this Sec. Cor. South To E.¼ 18 was 2610.55, it is now 2610.27 and again indicating a point near the Location as chosen.

Note: that M.C. - 159.09' North is To be used in locating this Section Corner in the future.

Note that an iron Rod set ± 254' East (over)

in April 1970 probably should be moved North To coincide with the location of the Sec. Corner.

Gov't Notes [illegible] 1854

80.00 Set stone post to corner section 7-8-17-18

Bur Oak 24 S 59 W 345

Elm 24 N 89 W 325

Bur Oak 18 N 74 E 503

Bur Oak 12 S 29 E 357