3-29-73 found stone with pipe up 3' by to side - left as is.

#841405 (1.)

section corner 14-15-22-23 Aroroco 108-14.

11-1872 Hunter P 211 no 219 & 15 C Morton.

Corner gone but all B trees standing.

Reset corner by B Trees.

-16 west set stake N & L. 19.98½.

6" Br Oak. S 15° W 67 lks — 10" Br Oak. N 12½° W 92 lks.

44.22 60.92

5-1919 Ch Armstrong P 308 B. SW¼ & 14 King.

found stone monument as SW cor. 14.

-16 east found stone mon at 1312' & BT stumps.

-16 center SW¼ 14. found stone mon.

from above 16 cor meas to waters edge 920' elevation

west 560' — north 675' east 890'

1941 J Kerr B 23 A Power dam survey.
found limestone in pit with 3/4" pipe up 3' on W side.

– 8" white oak		S & W	31.2.
–10" " "		W & W	26.9.
–18" hollow tree	orig grt B tree.	N E	35.6
–12" oak		N E	51.0
–12" birch		S & E	40.0.
oak		S W	50.0.

Power Dam Survey (1916) found stone

Card # 2. 14-15-22-23 Oconee 108-14 (2)

3-29-73. easily found. 4"x8" top limestone up 4" with 3/4" pipe up 3" on west side. #841405

noted 1 original govt witness tree listed in govt records.

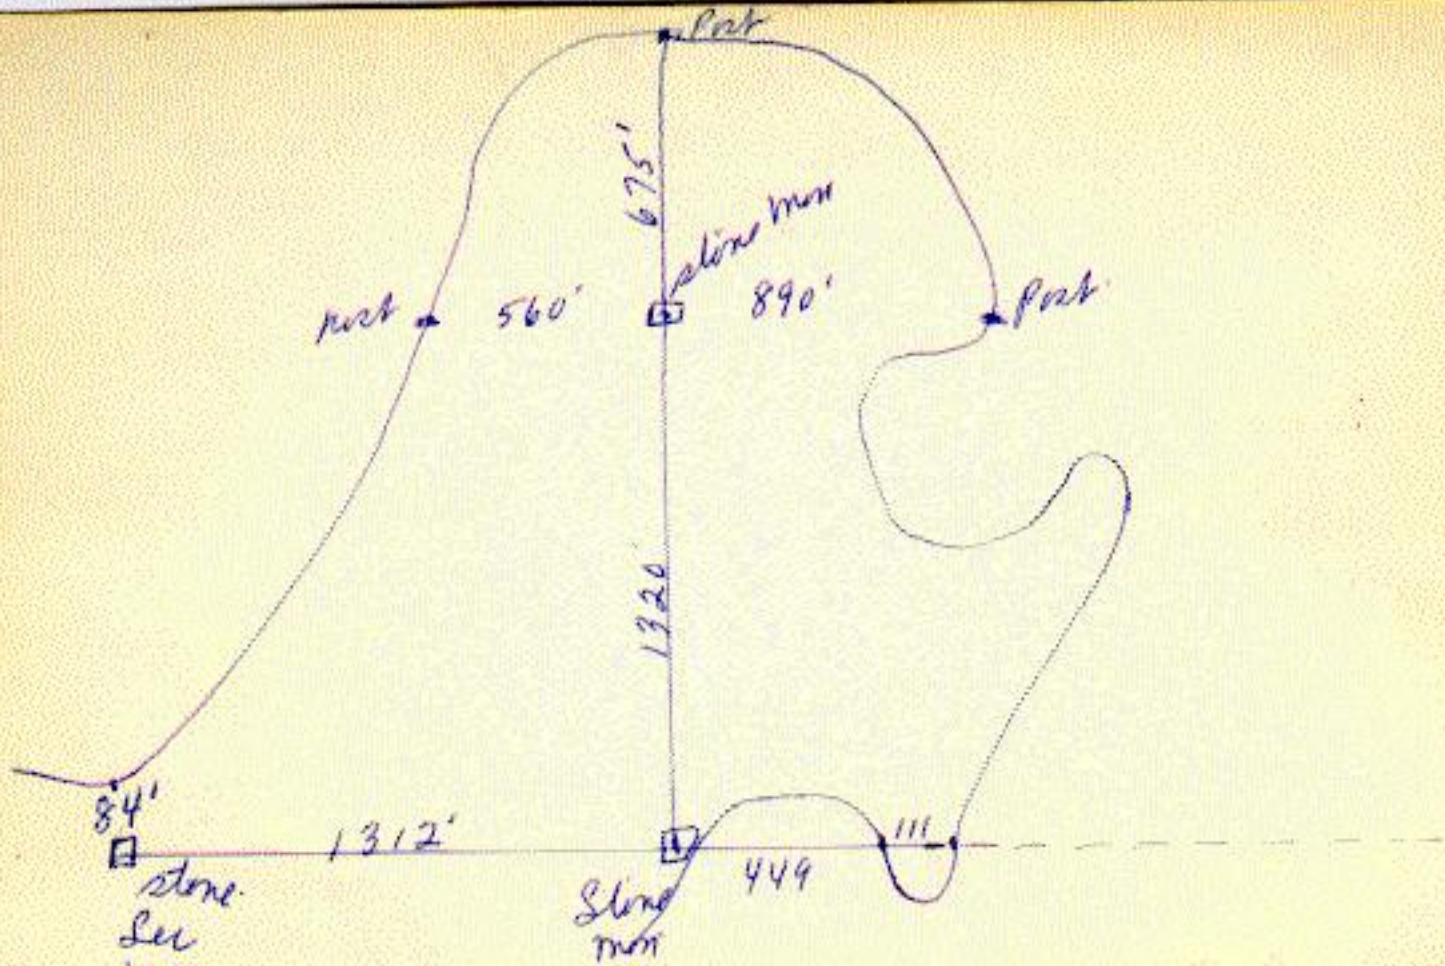
12" Jack Oak N41E 54 chs 35.64 tree now

36.1 ENE to large dead oak tree with large open hollow part toward corner - tree may have some life? (very few left in county now)

16.3 E to blazed 12" wh Oak

31.5 W to blazed 16" wh oak both trees on same contours as stone. (land steep).

27.2 S to blazed 16" wh oak up steep slope to head bed Rail corner. may line with fence running south & ridge road south. which has brick clumps west and huge wh oak east with dimple blaze up 6' ±.


Post
675'
stone mon
Post
560'
890'
Post
1320'
84'
1312'
111
449
stone
Lee
mon.
Stone
mon
Armstrong record

Original section corner 14-15-22-23 (3)
#841405
Cor't W. to S. on N. Kannah 1554
80.00 Intersect W to S line 15 links
West on true line between sects
No. 16
14 & 23
80.00 set section corner
S 9° 41'