1/4 — 5-20-1970 set C/M over 3/4" x 2' pipe glass cane-eli ①
orig stone .9' north down 6"

1/4 corner 18-19. Aronoco 108-14

#841804

1913 4 surveyors brg survey P215 bottom half of page. "J"


To relocate NE cor 19 went west, found old post rotted off and lying on ground. post went 3' deep. found orig witness tree burr oak. N 63° E 58.08' proved post as corner. set sandstone 19" long. with top of 4 3/4" x 5 3/4" with cross on top. and 1/4 cut on side of stone. drove large spike in "weather hole" on side of stone. set new post marker 1/4 18 & 1/4 19. took new B.T. S 72° W 150.4' an elm tree.

- Length of line 1/4 17-20 to 1/4 18-19. 5273.8'

4-1938 JKerr B12-P60. P. 54-55
run line from SW18 to S¼18. 2507.5
found both corners. - 1187.75 at 1/16 then 1319.75.

P. 55	RP's To	S¼18	
B.T.	N 56½°E	57.6	20" B. Oak (Orig. BT.)
	S 24¼°E	12.7	8" Elm (2 blazes at Root + 4' up)
	S 42° 30' W	53.5	20" Elm (2 blazes)

1966 Meas from. SE18 west drove nail in S side corner post & fence east. claimed set for commence by W Stolp & neighbor. had no idea where corner is. Meas. To nail from east. 2625.7. R 2636.9 11.2
meas from west (hole dug, no corner) to nail 2492 R 2507.5
found 1/16 fence north at 30' too far east
BT N 63° E 58.08'

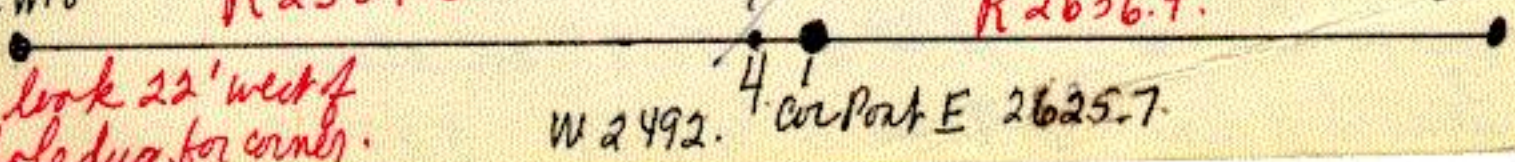

#841804

(2)

Card no 2 1/4 18-19 Alonzo 108-14

5-20-1970 Co Surv. drove truck to corner location. used transit from old B tree but found stone by probes. only slightly. brok N 63° E 58.08 exactly 58.08 to center of tree to stone easily found, sandy limestone with large nail driven thru stone but. S 76 30' corrected (can't make stand bearings and dist S 72° W 150.4. (found depression where stump was) was S 69° W Its apparent any bearing allowed very little of any for correction. stone recorded size 5 x 6 top 14" long with nail in side of stone. size matched perfectly also day hole below stone of old stake.

set 3/4" x 2' pipe in stake hole with beer cans glass & black top below C / M. - set orig stone (down 6") • 7' north of C / M.

set 1" pipe 5' long up 30" abnt. .6' east of CIM.
RPS corner 3' east of new N-S fence.
" 10' south of E-W fence running east.
flared 9" elm N 77° E 7.8'
orig B-tree now 6'6" circum. N 59° 30' E 58.08 to center.
24" elm in fence south unwrapped S 23° E 13.0'
– Note it apparent the 1913 meas of 2636.9 is bad as
1966 meas 2625.7 to corner post or 2628.7
– Meas west 1913 2507.5

Cor 40.00 Set Iron Pipe 1/4 Section Post
W 89° 51' E on true line between Set
38.00 Set 1/4 Stone Post
White Oak 10 S 23 E 155
Bur Oak 8 N 63 E 88