#842004 (1)

1/4 corner. 20 - 29 108 - 14. Oronoco.
8-1871 Perry by Hunter P188 no 199 & 20. Godell.
corner gone. next corner M & L. 39.88. (2632.1'
- 10.62 east to center St Paul terr. road.

7-1912. Ch Larson. P196 B. & 20 J Clasen.
set stake - likely M & L 39.88. 2632.08
- 10 62 east to center highway

1913. Hanneyer by survey. P219 bottom page.
set 1/4 corner M & L came 1' south of fence. used to set center 20. Plat shows iron stake set as corner.
M & L 2640'.

4-21-1975 dug around Kerr's pipe down to clay - did not find anything

- over -

4-21-1960 J Kerr B 78 P75.
Meas. ℄E on 20 long established corner west to ℄ loop road. 5267.0 - set ¾" pipe at 2633.5 early R 2632.1
- pipe came 2.85' south E-W fence. Set homesite SE corner.
at 1988.77 west of ℄E 20. then 165.5 E-W length of homesite



AZ 2. 345° 29'
" 3 253° 05'
" 4 167° 31.5'

8-12-70 Co surv. found pipe
Set 4-1960 by J Kerr N & L 2633.5.
35.5 E to fence running ℄ (2nd fence west)
Meas met with pipe as OD.

found ½ fence wires at 1316 ± - Cont measuring west.
set 120 D in middle road at 2632 on random chainage line
some 5'+ ℄ of fence line E - nail in small elm N S on this line
at 2608.3 - 5-4-72 found 120 D and dug at ℄W 20 found nothing
but huge boulders massive. Will accept ¼ Sec-29 as is.

(2)

¼ Cor 20-29 108-14 Otonwa #842004


9-22-1977 Mn/Dot provided RP's to pipe

Show corner 3.5 South of E-W fence

① CN & D in corner fence post up 1.5 on N side ENE 35.77

② CN & D in brace post up 2.0 on South side ESE 37.49

③ CN & D in fence post up 2.0 on SW side SE 66.79

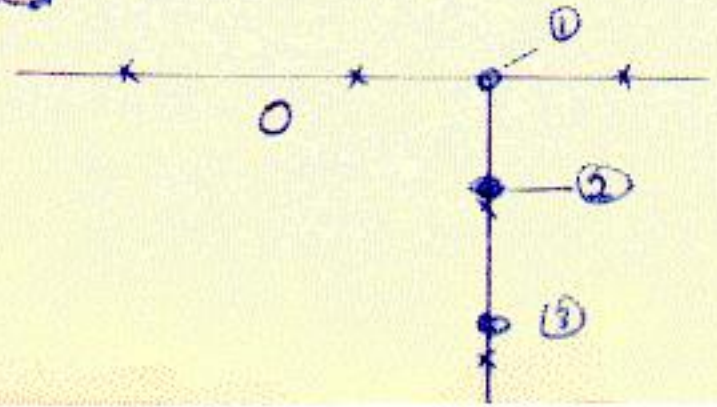

Govt Works M. Kansas 1854
40.00 set stone 1/4 section post
West on true line between sections
20.29 W 8° 30'
40.00 set 1/4 section post in mound with
stone, pits, charcoal stakes and Ogee
Orange trees N. E. & S. W.