#842406

1/4 Corner 23-24 Aronoco 108-14

5-1877 Hunter P308 no 302 S24&25 Rowley, Webster. Starr & others.

found orig corner standing tested NE B'true.

-16 east set stake N&L 19.91½ (1314.4' to boulder set. Center 24.

-16 south set stake N&L 19.87½ (1311.75' to boulder set. SW 24.

-16 center SW¼ 24 at true intersections.

5-27-1975 Co. Surv. - dug here on Location brought in by WHKS Traverse. - did not find anything after digging over about 5' dia. set nail and Tied it to Spk in W. side blazed 6" Elm - South - 12.3
Spk in N. side blazed - 10" Elm - West - 9.96

Will run Trav. of our own To check This location.

Power Dam Survey (1916) used M&L point as Corner

Measured 26256 North & South


4-28-78 Set a CIC/p² by doubling the 1/16th South set by W.H.K.S. on surveying the plat of Evergreen Acres. We dug [redacted] at the 1/4 corner and the 1/16th South in 1976. By doubling this 1/16th corner to the 1/4 corner ~~we followed the fence line quite well all the way to the E 1/4 24~~. There is no fence between the 1/16th and the 1/4 corner


R.P.'s Spike in W. side 7" Elm S.S.W. 12.18
Spike in N. side 12" Elm W 9.95
Spike & disc in 14" W. Oak NW 25.99
Center 20" W. Oak N.N.E. 22.0
Spike & disc in 10" Burr Oak N.N.W 58.51

Set a post & sign 1.0 ft North of the CIC/p²

ALBINSON, Inc. 1401 Glenwood / Minneapolis 55405 / (612) 374-1120
IDS Center — 34 Concourse / Minneapolis 55402 / (612) 341-3278
Northstar — 233 Cargill Bldg. / Minneapolis 55402 / (612) 339-7874
Southwest — 4930 West 77th Street / Edina 55435 / (612) 835-2141

from WHKS Trav. Survey March 1975

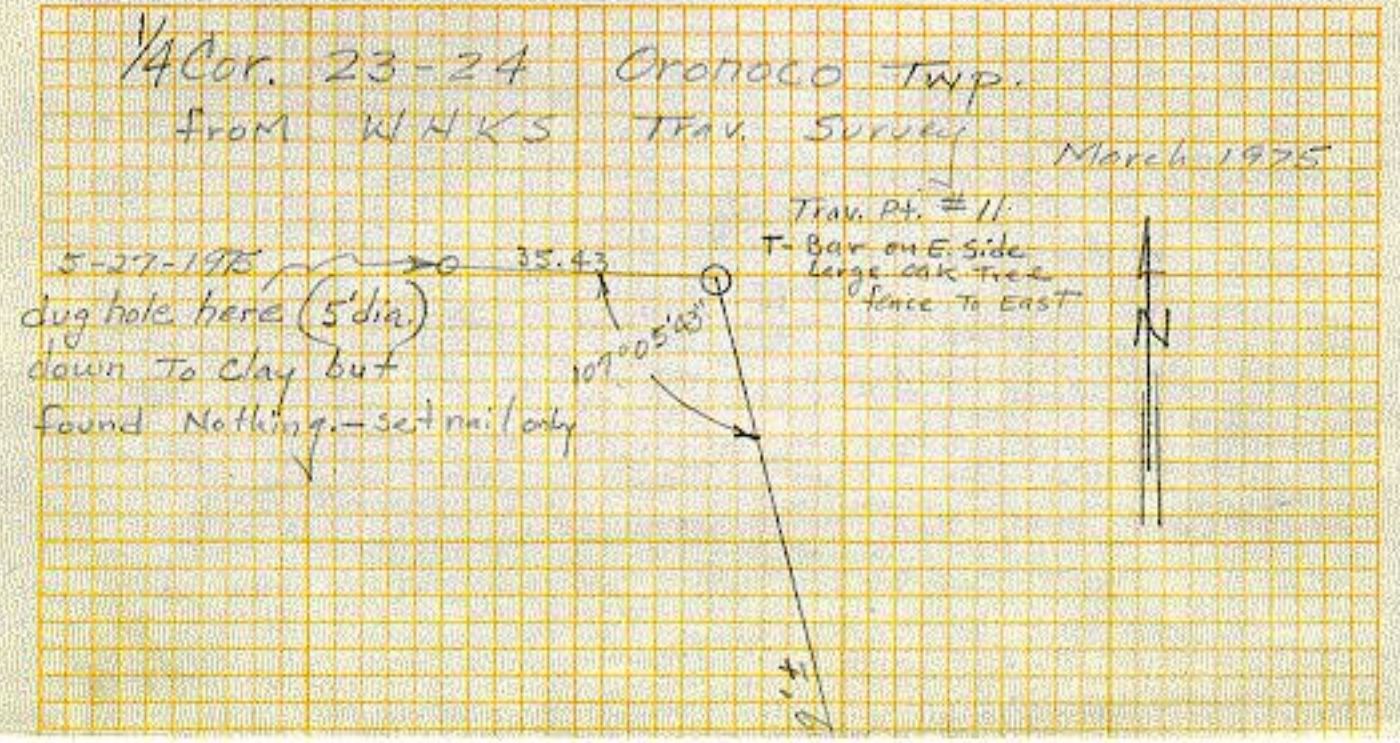

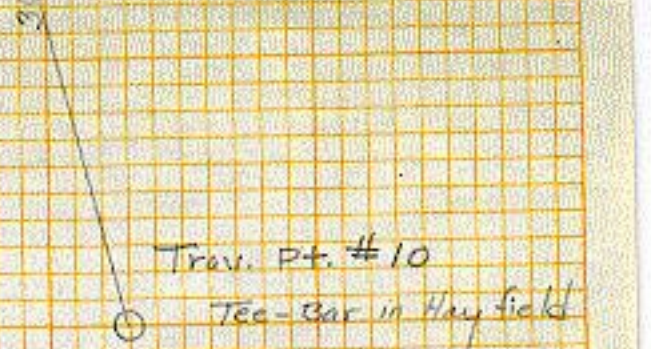

Orig. Gov't Brg. B.T.'s 1/4 Cor. 23-24

Br. Oak 12" S 31° W 382 lks

Br. Oak 8" N 44° W 150 lks = 99'

Looked for this tree or its remains on 5-27-1975 but could not locate any evidence of it as it would come on rocky ridge (just slight ridge).

Oronoco 1/4 corner 23-24 #842406 (3)
Geo Watts N. Knock 1854
40.00 Set 1/4 section post
Bur Oak 12 S 31 W 382
Bur Oak 8 N 44 E 150