11-1-67 set C I M over 5/8" x 12" rod M & L 2624.05 (1)
5-10-72 pulled C/M reset with temp corner #84784
1/4 corner 28-33 9-29-77 C I M Oronoco 10 8-14
6-1867 H Horton P85 no 131 SE 1/4 28, NE 1/4 33, NW 1/4 34.
used corner - set 1/16 south M & L. 19.90 1313.4

3-1896 H Fraser P592 no 538 E 1/2 S 28, W 1/2 S 27.
S Hall, H Vroman
found remains of old corner in center road, set new corner.
-16 east located corner M & L. 19.93 1/2. (1315.7'


11-1912 D Williams P186B NW 1/4 S 33, NE 1/4 S 32.
J J Reiter
found long granite boulder with rotted stake beside it in center road.
set new stake also beside stone.
-16 west found limestone with 4"x6" top & old stake beside it.
(note this 1/16 corner be S of 28-29-32-33. M & L. 1313.4 -over-

-16 south "1" (Cor. for 33) found boulder at fence running east which was assumed to be center 1/33 "N" but way out of station.
- 1312.5 from N 1/4 33 to 1/16 south "1" then 1326.5' from the south to boulder, but found lengthy rotted stake 15' north of boulder. Making 1312.5 and 1311.5 left both as is as it was getting late & end of job.

1966 I Can Meas north line 33 carefully. = 1/16 fence north at 1305.5 ±2' 1972 R 1313.4. then fence north at 2621.0 R 2626.8 From West
- entire mile at 5248.1 - dug extensively on sloped road.
- set C/M. over 5/8"x12" rod M&L 2624.05' corner gone.
- green steel corner post - point of angle. NNW 22.35
- concrete post up 18". S 36.8.
- bottle cap. in power pole. NNE 24.0.
- corner lies 3.5" E of fence N= 4' north center E-W road.
- 5/8"x24" rod under fence. NNW. 100'

Card # 2. 1/4 28-33 Ariz 108-14 #842804 (2)

4-26-72. found true corner at 28-29-32-33, 2 limestone 2x6x15 each with old slab between set by Hunter 1873 and found by D Williams 1913 P 186 B. (1/4 28-33) stones 2' west and .3' south of C/M. so C/M as set now not M&L 2624.05 as set 11-1967

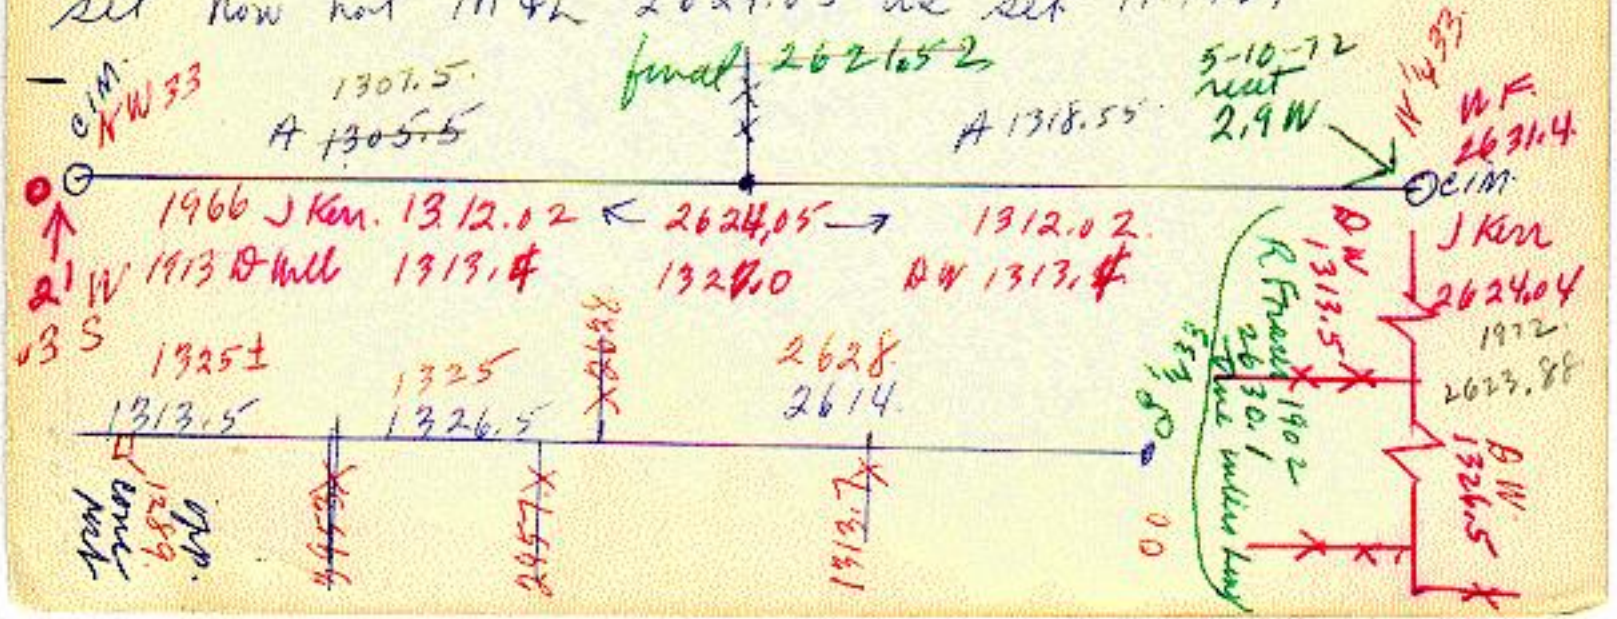

4-27-72 dug entire S ½ traveled road. to cover all possibilities
4-28-72 dug rest of S ½ and N edge ditch (nothing).
Remeas line from 27-28-33-34. 2623.88 WF 2631.4
Meas carefully from above 1311.82 then 1312.06
only thing left to dig Center road north from C1/4 west entire N ½ road.

5-10-72 Co surv reset corner Lee card 3
final RPs Rod under fence N 99.95 L E to rod 90°16'
- set transit on rod. with shot on final corner took AZ
to PI Power pole ¼ mile S. with 3 insulators
L corner to pole 19°55' - drove 60D in apple 111.4 SW of corner
Center apple tree lies 4.4 west of transit line
corner 35.7 N of 5242 nail on 5277.7 S to S ¼ 33 iron

Card # 2 1/4 28-33. Conoco 10-14 #842804 (3)


4-26-72. found true recorded 2 limestones and slab between at 28-29-32-33 each 2x6x15 set by Hunter 1873 and found by Williams 1913 P186B. 2'W .3'S. CIM.

5-10-72 remeas from 28-29-32-33 east now true corner
- found 1/16 fence N at 1307.2 1966 1307.5 corrected for new er
- found fence N at 1/4 cor very near 2623± same as 1966
but found CIM at 2625.05 Ken M & H corrected at 2626.05

reset corner on direct new line 2.9' west of CIM.
Ot. Meas E now 2626.78 west 2622.15.

- reset 1/16 corner east 1.57 further west on line of 1313.39 M&L
- set 1/2" rod 60' N at 1/16 no other RP
- found 5/8 iron at 1/16 west at 1313.4, .29 N of direct line of mile true M&L 1311.08

Lee Card # 2 mea RP 1/4 28-33

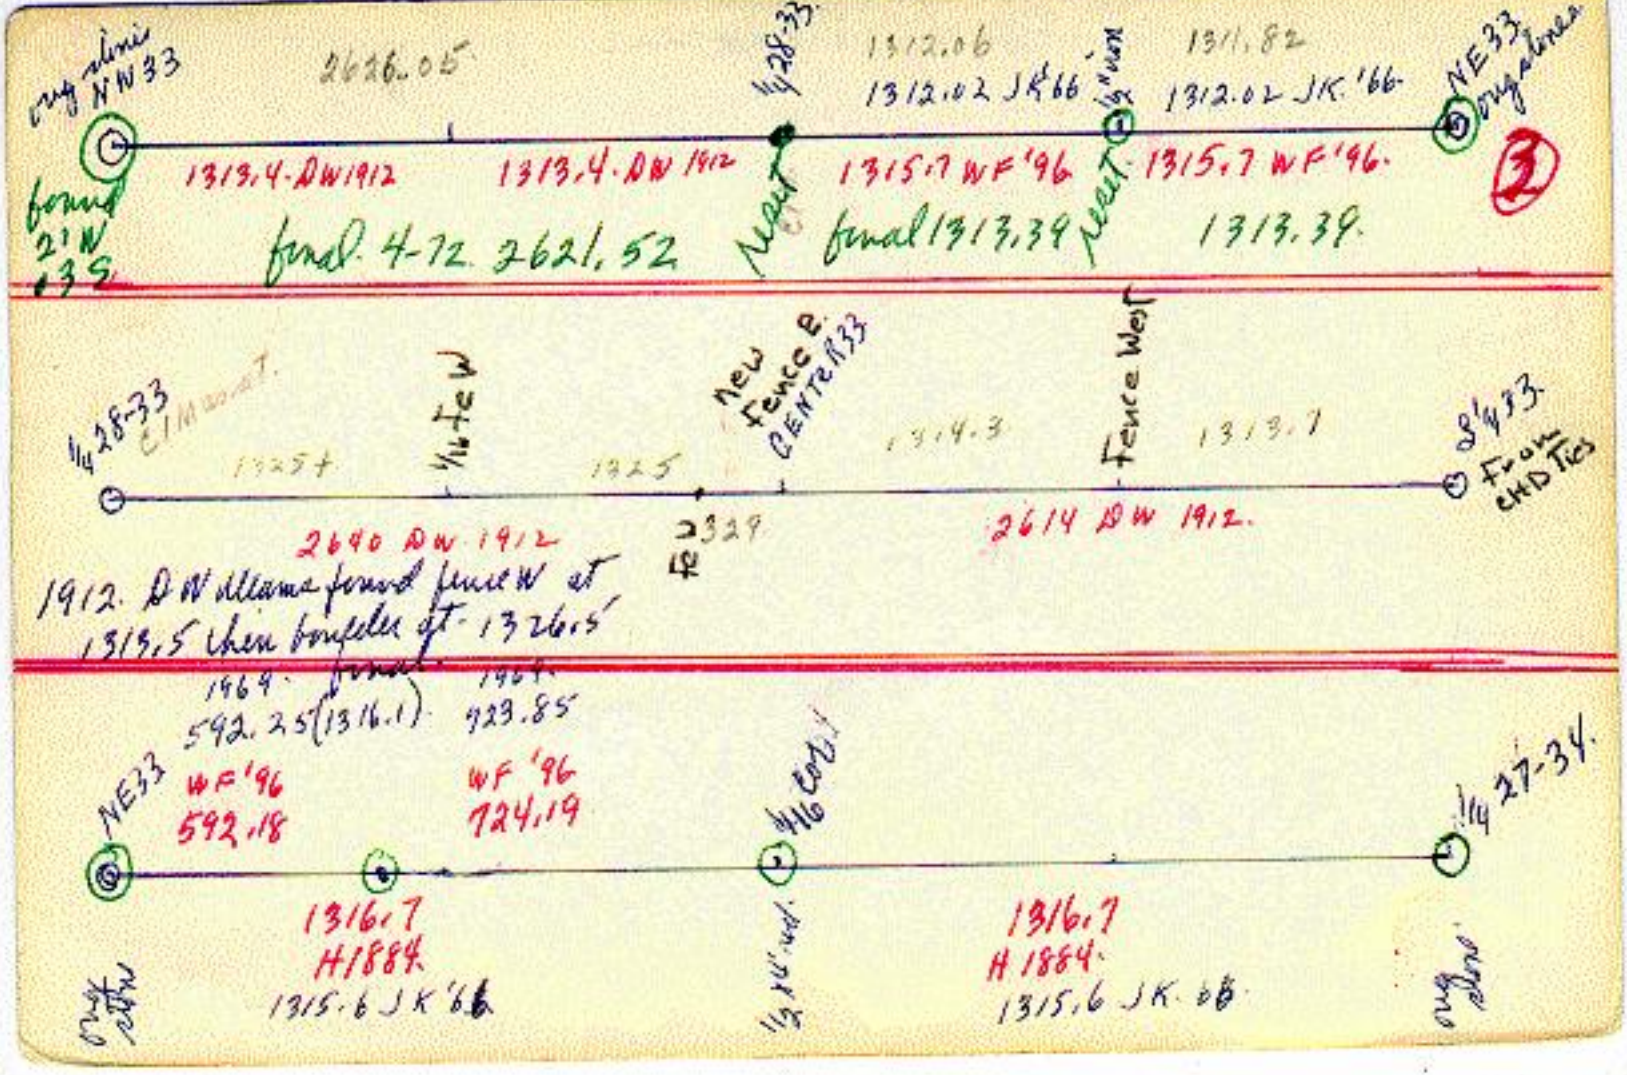
orig. stone NW33
2626.05
1/4 28-33
1312.06
1312.02 JK'66
1/4 mon.
1311.82
1312.02 JK.'66
NE33 orig. stone
3
found 2'W 3'S.
1313.4-DW 1912
1313.4-DW 1912
Mean
1315.7 WF '96
1315.7 WF '96.
found 4-72 2621.52
found 1313.39
Mean
1313.39.
1/4 28-33
Elm 20" D.
1325+
1/4 to W
1325
New fence & CENTER 33
1314.3
Fence West
1313.7
S 1/4 33.
From CHD Ties
2640 DW 1912
2614 DW 1912.
1912. D W Williams found fence W at 1313.5 then bonfire at 1326.5'
1964. found
592.25 (1316.1)
WF '96
592.18
1964.
923.85
WF '96
724.19
NE33
1316.7
H 1884.
1315.6 JK '66
1/4 N. mon.
1316.7
H 1884.
1315.6 JK. 66
1/4 27-34.
orig. stone

Card # 4 1/4 28-33 Aroroco 108-14 #842804 (4)

7-2-1902 Robt Fraser old fieldbook # [10] P 53. S 33

at "B" found stake and boulder. stone head N. East Chaon

"B" to "C" chord 28' lks 18.98 or (2622.52 final 4-72. 2622.15

"B to 2" (center 33) chord 15. lks or (2630.1

Summary 4 meas S.

Horton 1866 set 1/16 S at 19.90 N&L 1313.4

D Williams. 11-1912 found boulder S at 1313.5 at fence run west

and boulder at 2640 but rotted stake at 2625± left both as is.

JKer. 1966 set 1/4 28-33 N&L meas S found 1/16 fence W at.

1318.3 .00 at 1/4 28-33 very near final maybe .15 North of present

set iron at 2627.0 or 8.7' north of fence east.

5-1972. meas carefully from S 1/4 33 as per Co RP 39 iron north.

found 1/16 fence west at 1313.7 and new fence east at Center at 2628

over.

#842804 (5)

¼ Corner 28-33 Oronoco 108-14

9-29-77. Set CIM over 5/8" x 8" rod from 1972 RP's. Finial corner came .05' N of rod (removed) probably set by CHD. Corner now line with fences N and S. and is in ℄ E-W road.

RP's Rod on W. side of fence N (see card #2 for transit tie. N 99.95

60d in apple tree SW 111.40

NW corner of concrete corner post (up 2') S 57.95

Govt Notes in Knock 1854
40.00 Set temp 1/4 sect. post
West on true line between sects. 28+33
40.00 Set 1/4 section post in mound 5°SE
with trench, pits, charcoal stake,
and Osage Orange scribs at each
angle

6-4-98
Found CIM@ Surface of CR#154 in good Condition Set Ref
pipe w/cap on East edge field drive South 8½' west of
fence line south
↑ @ Ref pipe
↗R+PK Nail in pp# F14-33-18.0-9.5 (1st pole East on So side CR154)
to 1/4 Cor 28-33
↗ = 280° 14' 22" Hor = 53.495

48 "842804" J 6-4-98 MW EA MC

√1/4 Cor 28-33 108-14 Oronoco
Found CIM @ Surface of
CR# 154 in good Condition
Set ReF pipe W/Cap on
East edge field drive South
8 1/2' West of Fence line South
↑ @ ReF pipe
↓Rt P.K. Nail in PP # F14-33-18.0-9.S
(1st pole East on So. side CR154)
to 1/4 Cor 28-33

280° 15' 24" dh 01 | 282° 15' 09" dh 00
0° 01' 01" dh 01 | 2° 00' 48" dh 01
280° 14' 23" | 280° 14' 21"

To 1/4 Cor 28-33
VA 90° 12' 12" dv 02
Slope 53.495 Hor 53.495

"842804" 1/4 COR 28-33 108-14 6-10-99 EA MC MR
FOUND PK NAIL SET BY SURVEY CREW @ SURFACE,
SET 1" SQ PIPE W/CAP AS FINAL CORNER. CORNER
FALLS IN ℄ CR #154, IN LINE OF FENCES N + S
± 22½' E OF ℄ FIELD DR SOUTH.