X 5-8-72. found 6x8x18 stone - set iron by stone
#843109

1/4 Corner Center 31 Oronoco 108-14.


5-1870 Perry P112 no 149 & 31 Willson set boulder stone at true intrs lines.
- Meas west 38.27. (2525.8'
- 16 north set boulder stone as corner for 80 actual acres 20.90. (1379.4. this figures to 79.98366 acres.

1966 JKerr dug for corner stone by corner past set up. - set no corner - ground clean and nice digging no probes - Meas north from fence west. found 1/16 fence west at 1378.1 R1379.4 dug for boulder there.

-over-

found nothing. continued meas north on 30' @ W.
taking general line of N-S 1/4 fence (south half)
finally set rod as N 1/4 31 at 2521 from west and
2634 from fence west at Center (likely very near correct
as 1/16 fence north running west is so close). Coned probe
for center and 1/16 corner as well as N 1/4 31. large post
at center of main fence south and west likely very close.

5-8-92 Co surv. found stone easily with probe Co. 6X8X18
rem random aerial N as coned see only. Corner
set in 1966 at 1/4 30-31 not 1/16 stone found.

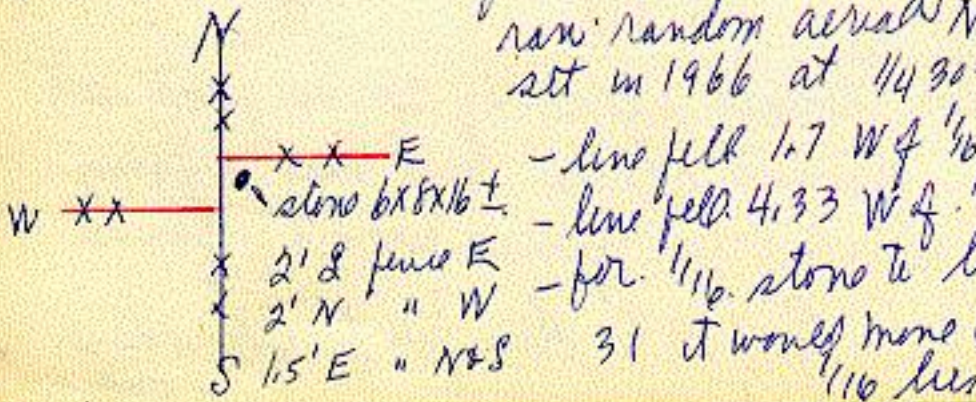

- line fell 1.7 W of 1/16 stone.
- line fell 4.33 W of 1/4 30-31 stone.
- for 1/16 stone to line up direct Center 31 & N 1/4
31 it would move only .57' each.
1/16 lies N 3' E of PP 23250