1 4-28-72 set C/M over 3/4 x 12" iron with aug. stone on West side C/M.

#843306 (1)

1/4 corner 32-33 Oronoco 108-14.

5-1873 Hunter P224 No 227 S 32 R Williams, A Hannon. Corner gone, searched carfully & diligently. Mr Hannon & son anered rail fence in place to have run to corner when standing. accepted fence line to run the E-W 1/4 line set no corner.

-16 north set point midway between fence & NE corner 32 19.97. no life.

5-1874 Hunter P249 No 250 S 32. A Moulton, Peters. set temp point at fence line 39.94 1/2 each of center 32 which would be the mean between north line E 1/2 32 of 39.80 and south line E 1/2 32 of 40.09 or 2636.37 set temp stakes on line west from E 1/4 cor. to set points south 9.98 5/8 - 9.98 5/8 - 16.00 and then 3.97 1/4 to center. -over-

11-1912. D Williams. P186 B. NE 1/4 S32, NW 1/4 33 J Reiter
Corner gone found evidence of others digging in area.
Relocated as in survey P. 249.
-16 west found stone and stake M & L 1318.18 avered
by Mr. D Clark that he helped set this as a previous survey.
-16 north found limestone with 4"x6" top M & L 1318.02.
- north set iron rod 329.5' north of point set as 1/4 32-33.

J Kerr.
run & meas line from N E cor 32 south over old gravel
pits & waster to 1/16 corner reported set by Williams. found
sufficient evidence and proof of corner to reset corner.
10-24-1967 B 96 P 63. found part of wood stake 1.5' long
2.5' west of corner post on S side fence set 1/2" rod - Meas 1317.3

7-1902 Robt Fraser - Field BK #10 P. 50-51
says set boulder stone on N-S section line & 1/4 line
run from West.

Card. #2. 1/4 32-33. Chronco 108-14. #843306 (2)

4-28-72 Co surv - offset 18' north at C/M at 1/4 31-32
- run random line east by setting 3 points and back-wiggling from near E 1/4 32. - temp 50° light wind - light drizzle at times.
- line came 21.65 north of 1 1/4" pipe set at center 32.
- meas again east. line came 23.26 north of 1 1/4" pipe set over 1/16 stone at 1318.25. (Williams 1318.18 1912.) 7-1970 1317.9.
- cont line & meas east - found vertical pointed boulder ± 7 x 10 x 14 very positively set for corner by D Williams ? = R.F. Book B P 186 11-1912 or R Fraser fieldbook 10 P 50. 1902.
- as meas a little short set C/M over 3/4" x 11" iron cast of stone (left in place) as final corner.
- corner at 1317.0 from 1/16 pipe and 25.66 south of random.
all corners do not align perfectly but within tenths, accept all as set.
over R.P.S. final.

long steel fence post .28' N of center CIM.

3.45 Westerly to 40 D nail out 1" in N side 15" maple
about (3.15 To center stone)

10.15 Southerly to 40 D nail out 1" on E side; southerly of 24" twin maples

11.45 northerly to 40 D nail out 1" on E side easterly sign pole

2.0 ± N to E-W fence

corner on high land just west of Hwy 52 2 BW fence.

#843306 (3)

Card # 3 1/4 32-33 Oronoco 10 8-14

7-1-1902 R Fraser old fieldbook no 10 P 50-51 S 32.
at "H" put boulder stone on line between albert Clason.
"A" and "G" for E-W and on line from W 1/4 32 over A-G shot 8L. 5274.72
Center 32. projected back and inters this line
meas west to dyke near "Fell"
meas north short 8 1/2 lks 5.61' with point midway. - 1/16 Cor
1/2 way. 1317.2 (S 1/2 not get measured) north 1/2. found
from stake to org corner 1317.3.
as NE 32 true corner. fell only .3' south of C/M.
meas now. 1318.9 no final mods 1/16 south!
(can't figure D Williams 11-1912 "corner" is or why
he didn't find stn as found. 4-28-72.

9-8-1977

Mn/Dot provided additional RP's:

40 d nail up 2.0' on ESE side Twin Maple SW 10.18

fence corner ENE 10'

℄ S.B. lane T.H. 52 E 85'

Govt Notes M. Kovacik 1954


40.00 set 1/4 station post in mound with trench, pits, charcoal stake, & orange Orange 5-15 N.E. - S.W.

6-5-85, 1/4 Cn 32-33 ° Took additional R.P.'s be road construction destroys corner (SBL T.H. 52)

#843306 (4)

1/4 Cor 32-33 Oronoco 108-14

6-5-85: Took RP's before road construction destroys corner.

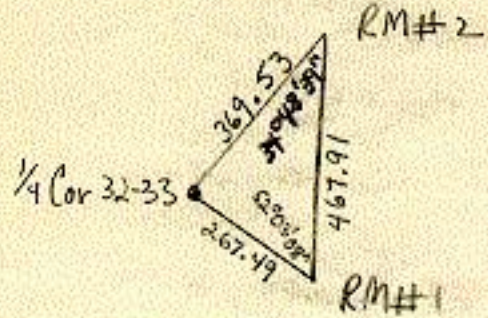

Use Brg – Brg Int.

RM #1: 5/8" re-rod 12.2± East of East edge concrete on NBL T.H. 52 and 3'± N'ly of center of 15" CMP under NBL. RP: Punch in lug at top East end CMP SE 7.01

RM#2: Mn/Dot BM T 5508 (disc in concrete) Point 1' West of B.M. sign & post and 2½' West of pipe C.P. to fence N-S-E on the E side of T.H. 52.

Also. Spike & CSD in N side 14" Maple (center Tree of 3) WSW 39.85

Mn/Dot R/W mon (aluminum cap on telepost) SW 100.99 (ch.)