
10-3-1966. set C/M one 3/4" x 2' pipe M&L 2638.6
Checked Corner location & used for locating Corner 34 (Aug 29, 1974)
1/4 Corner 33-34 Oronoco 108-14 ①
10-1913 D Williams P240 B L34. J.A Clason #843406
Run line from established old corner NW 34 south to corner
set on town line midway SE 34 and SW 33
- Corner not described but set M&L. 2637.6. for line E.
- meas east 2636.8 to corner set inters line.

---

line & fence corner used over center to help set & find.
E 1/4 34. which eventually was set likely M&L. which
is now an incorrect corner as set.
9-21-1966 J Kell. Book 94 P 65.
run N-S section line as Williams did M&L 2638.6
R 2637.6-over-

set C/M ones ¾" x 2' pipe M & L 2638.6.
corner came in common owned land. 9.3' north of E-W fence.
corner came 13.6' east of fence running south.
– large creosoted corner post of fence E-W-& SW 17.0.
– nail in hub in most westerly elm due E 174.5.

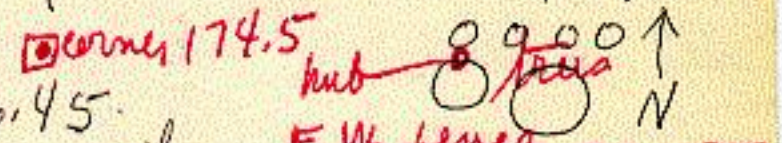

– 16 east set rod M & L. 1316.45.
this 1/16 rod lies 2.7' west of fence south
4.7' south " " E & W.

Mma E 2632.9.
D W R 2636.8

– 16 center NW cor 34. set 120 D on line at 1320'
from 1/16 rod on N side of NW¼ 34. – this 120 D lies
1' west of first steel post south of field fence running E.
as total meas was 2645.4 this 120 D should go 2.92 S.
to be a true M & L 1/16 corner & set on N-S 1/16 line only.
4-26-72 proved corner within • 1' by line Center 34 to 1/16 stone with + found 4-26-72

Oronoco 1/4 corner 33-34 #843406 (2)
Cast iron M. Kimball 1854
40.00 set 1/4 section post in mound
with brick, pits, charcoal stake
& Osage Orange stds W. E & S. W

June, 1867 H.E. Horton Pg. 85 No. 131 shows 1/4 Cor.
1/16 East 19.93 Chs M&L to Center Sec. 34
1/16 North set M&L (No Meas.)

4/16/90 FD CIM IN PASTURE IN GOOD COND. AND ± 9'
NORTH OF E-W FENCE & ± 13½' EAST OF FENCE
SOUTH AS DESCRIBED BY J. KERR