#850109

1/4 corner Center 1 New Haven 108-15.

6-1902 Ch Armstrong P54B Meyer Wright, A Inneman.

set boulder stone 10x12x16 at true inters lines.

Came 10' west of N-S fences.

-16 North set limestone 3x8x20 at 19.94 1/2 (1316.2'

then 20.41 (1347.06' to N 1/4 a stone set.

-16 center NE 1/4 set limestone 2x12x24. - found an old

corner. S89°W 9 chs not correctly run in, destroyed old corner


-16 center NW 1/4 set limestone 4x12x14. at inters lines

set witness stone 5' west of corner set a 5"x11"x14" gra-

nite boulder marked witness corner on east side.

-16 west set boulder 4x16x20 with iron stake below N&L. 20.08 [1325.28'
-16 south found old stone N&L 19.78 (1305.48'
stake line east for fencing.

Section 1 - 108-15

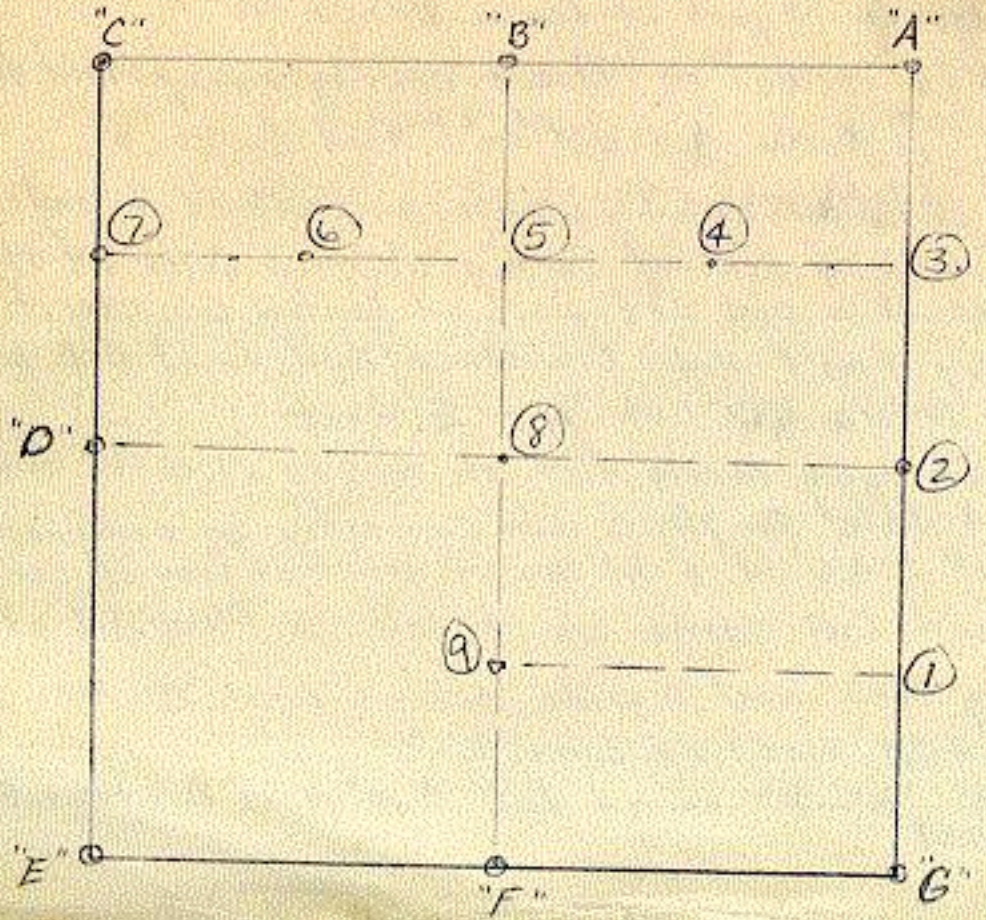

Corners searched for in Dec. 1974 by County Surveyor.

See over this sheet for details

See Sec. 6-108-14 Sheet for details on Corners "A"- ③, ②, ① and "G".

"C" - Set nails over mons without digging up about 1' of frost
"D" - Set CIM over rod on line "C"-"E" and prorated C. Armstrong Msmt.
"E" - fd Kerr's CIM. near Cor. to post of fences E-W & N.
"F" - fd CIM. in group of rocks no fences near by except old fence
(4.) dug for C.A. Stone at 1/16 Cor. but did not find it
(5.) fd stub of fe post with pieces of limestone all around it and another stub on N. side & present Cor. f. post on S. Side of it. used this Center post stub and set piece of pointed L.S. over it.
(6.) fd - Stone (7"x15") Top down 1' under E-W fence and found C.A. boulder. Witness ~~Stone~~ with letters W.C. on Top - 5' West
(7.) fd - 1½"x 14" iron shaft lying nearly flat on N. Side of E-W fence Could not find rust hole To place iron correctly so removed it. New Corner would fall ± 4.6' W. & 1.1' So. of point of iron if setup.
(8.) did not Try To find C.A. Stone as it falls in Plowed field.
(9.) dug hole ± 6' long N-S and 2' wide across Line "B"-"F" Point (5.) only about 0.4' west of Line "B"-"F" Prorated meas. of "B"-"F" would fall ± 4' N. of line fence East across Road To East.