
11-17-81 Set C.I.C./P²

#850306

North Section Corner 3-4 New Haven Twp. 108-15

Govt. Notes- John Cushing, Dept. Surveyor 6-12-1854 80.60 INtersect Standard Paralel No. 2 11 chs. 41ks. East of 1/4 post on south line section 33 in Twp. 109-15 and set post for corner to sec. 3-4 . Erected mound with trench and pits and charred stake per Instructions. Land: Rolling prairie 1st rate.

11-3-1981 Dug under E-W fence and in line with break between Corn field and Hay field to South and 728' East of Ron olson's ribbon on fence at SO. 1/4 33

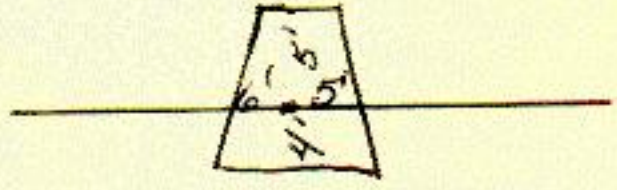

Dug 2½' deep to Clay

found Nothing

(over)

11-17-81 set C.I.C./P² at Gov't Meas. from So. 1/4 33, 109-15 and on the line From S 1/4 Cor. 33 (small post mark fd.) to So sec. Cor 33-34 (stake fd.) Corner 1.5' So. of Survey Marker Sign & Post in E-W fence line and 117' East of drainage Ditch.